

Name James Gaudet
 Address 76 Endicott Avenue, Somerville

Service No. ~~#~~ 707
 3101

Location #3 Daniels Street Lot # 76

Kind of Pipe Size Size of Main
 Repair—Renewal—New Service Location

Date	Material	Amount	Total	Date	Amount
1938					
June 8,	2 hrs . @ 60¢		1 20	May 31, 1938	15 00
July 7-12-38	58' 3/4" Cop. Tubing @ 20¢		11 60	July 12, 1938	14 00
	1 3/4" Union (3 parts)		1 10		29 00
	1 3/4" Bushing		30		
	1 3/4" S. & W.		3 75		
			<u>17 95</u>		
	Flat Rate 58' @ 50¢		\$29 00		
				on sewer ac't #16	
				Refund of \$14.00/to be credited to this	
				acc't.	
	Labor				

Hadley Press, Inc., Lexington

DATE _____

TOWN OF LEXINGTON—BOARD OF PUBLIC WORKS

WATER DIVISION

The undersigned applies for a supply of water at No. 3 Danville St St. and hereby agrees to comply with the rules and regulations as now, or at any future time, established by the Board of Selectmen.

Am't. of Estimate \$ _____

Owner James Gaudet


Am't. Paid \$ _____

Address 76 Edwinst ave

Builder _____

Somerville

Sketch of Service Here

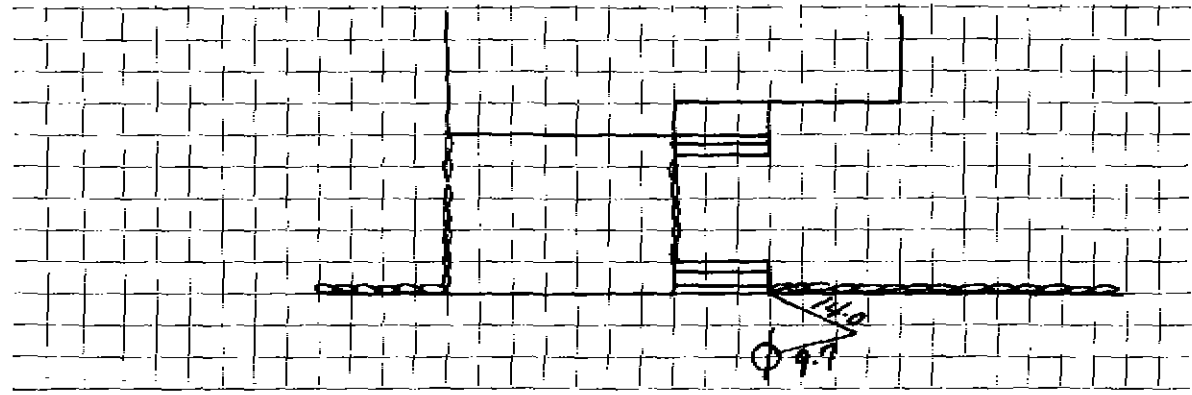

Connection made in _____ Street.

Work completed _____ 19

Remarks: