


DATE _____

TOWN OF LEXINGTON — BOARD OF PUBLIC WORKS

WATER DIVISION

Sketch of Service Here

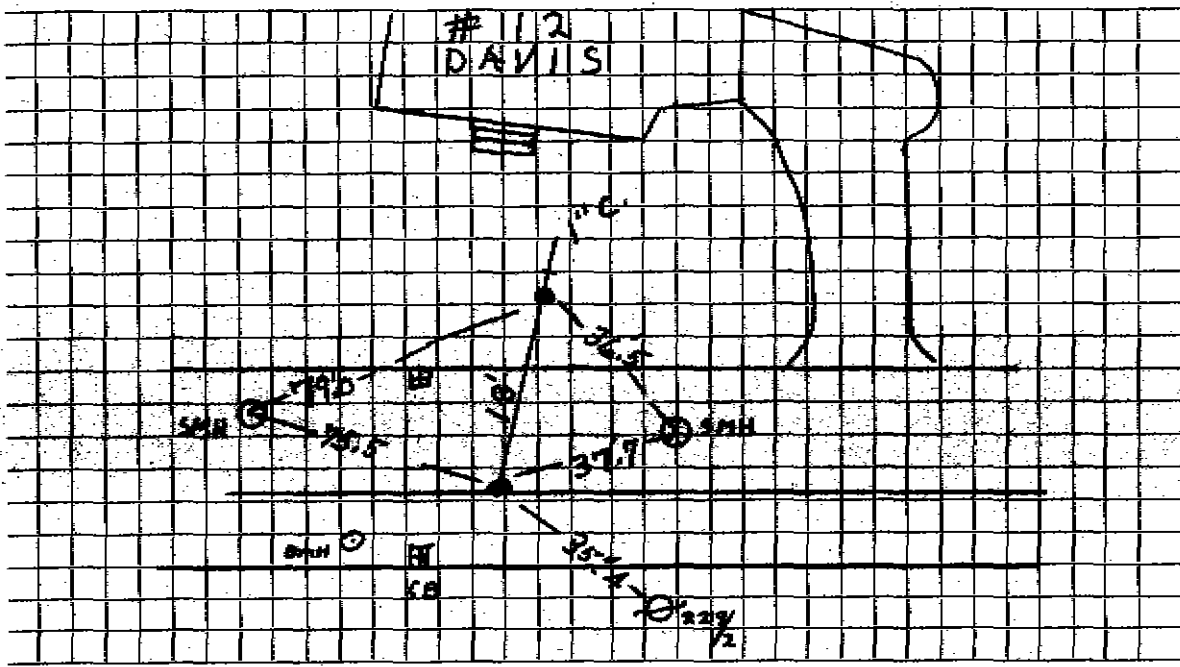

Connection made in Davis B.D. Street. Work completed 7/30/09 P.A.O. Corp.

Remarks:

.....

.....