


DATE _____

TOWN OF LEXINGTON — BOARD OF PUBLIC WORKS

WATER DIVISION

Sketch of Service Here

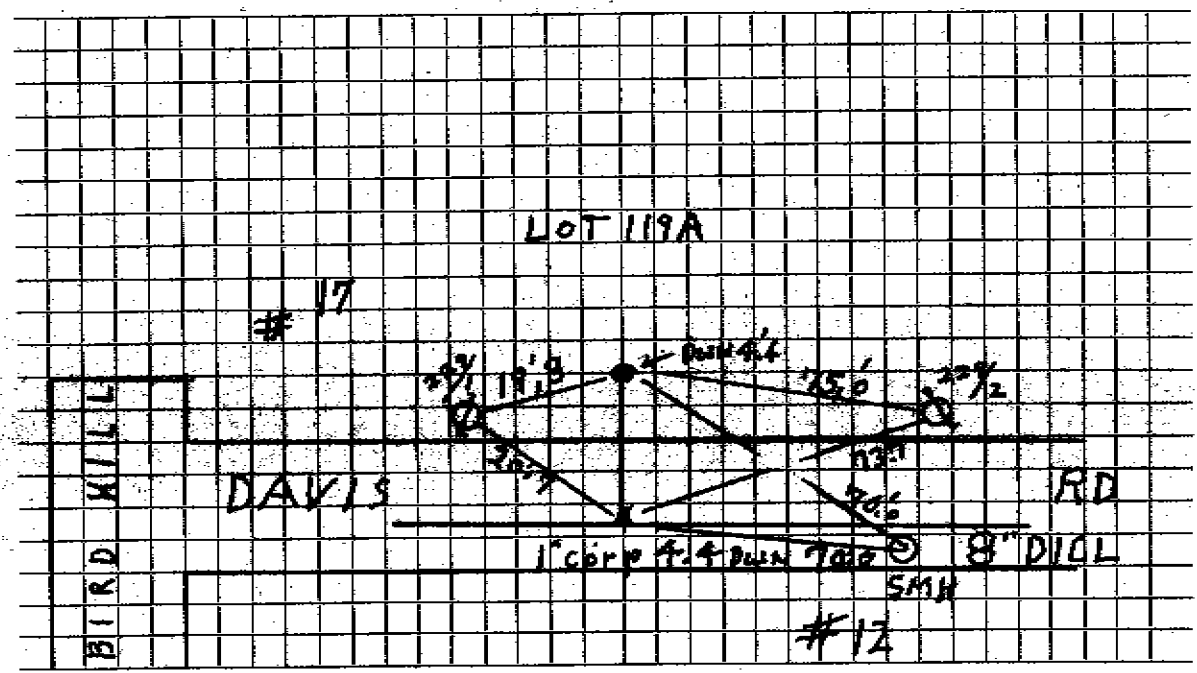

Connection made in DAVIS RD Street. Work completed 7/30/09 P.A.O Corp

Remarks: 4x4 @ curb box