

Name

WATER SERVICE RECORD

Service No.

Address 17 Davis RD

Location

Repair—Renewal—New Service

LOT 32 A

Date	Material	Amount	Total	Date	Material	Amount
10/30/80	35' 3/4 Copper			7/30/09	21' P.A.O Coup 1" Copper 1" Corp 1" Curve Stop 1 1"x3/4 Redi buffle box	


Dist 4.6'

DATE _____

TOWN OF LEXINGTON — BOARD OF PUBLIC WORKS

WATER DIVISION

Sketch of Service Here

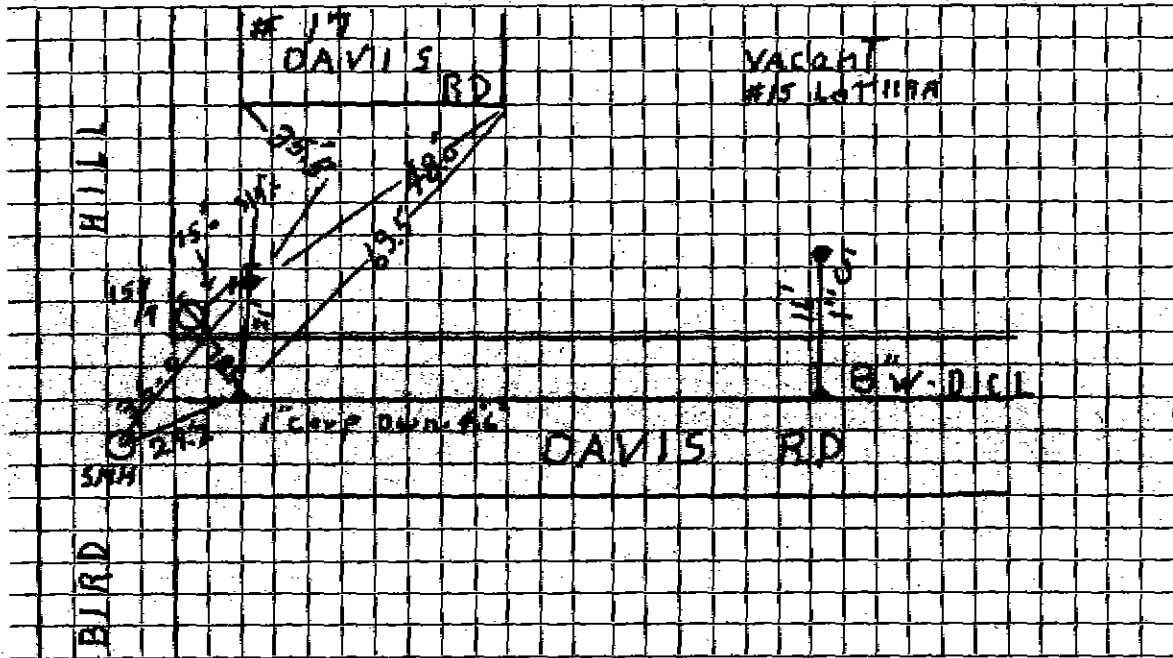

Connection made in Davis RD Street. Work completed 7/30/09 PAO-Corp.

Remarks:

.....

.....