


DATE _____

TOWN OF LEXINGTON — BOARD OF PUBLIC WORKS

WATER DIVISION

Sketch of Service Here

LOT 14

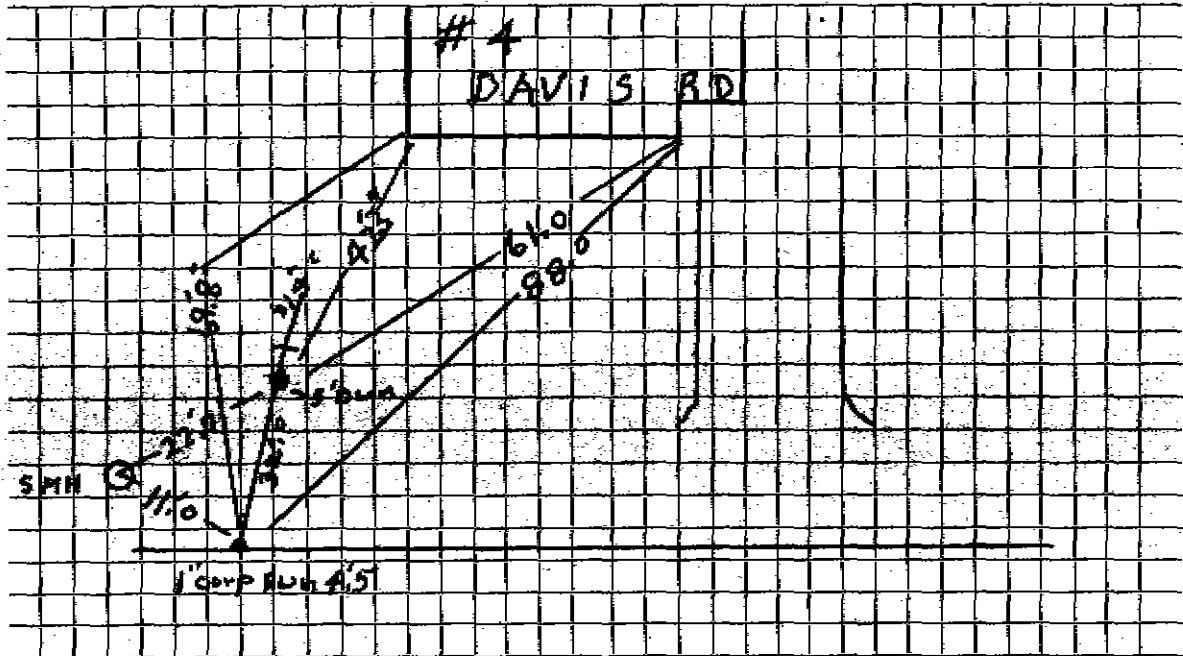

Connection made in Davis Rd Street. Work completed 6/12/09 P.A.O. Corp

Remarks:

.....

.....