

### WATER SERVICE RECORD

Name L. H. Hewett Jr., Inc.

Service No. 31

Address 5 Davis Road

Location

(Service on Rockville) Lot 40 A

~~ESTABLISHED~~ New Service Hewett #3497 W.O. #0837


JUL 7 1980

Date	Material	Amount	Total	Date	Amount
6-19-80	Labor	19.81			
	10% O.H.	1.98	21.79	11-31-79	Deposit 250.00
	30' 3/4" Copper tubing	8.94	28.20	7-7-80	Refund 187.26
	1 3/4" Corp		13.90		105.94
	1 3/4" Curb		21.05		
	1 Box & Rod		17.80		
	1 hr. Trucking		3.00		
			105.74		
6-23-80	51' 3/4" Copper tubing (Great Northern)				
				* Apply 7284 to W.O.#037	

TOWN OF LEXINGTON — BOARD OF PUBLIC WORKS

WATER DIVISION

Sketch of Service Here

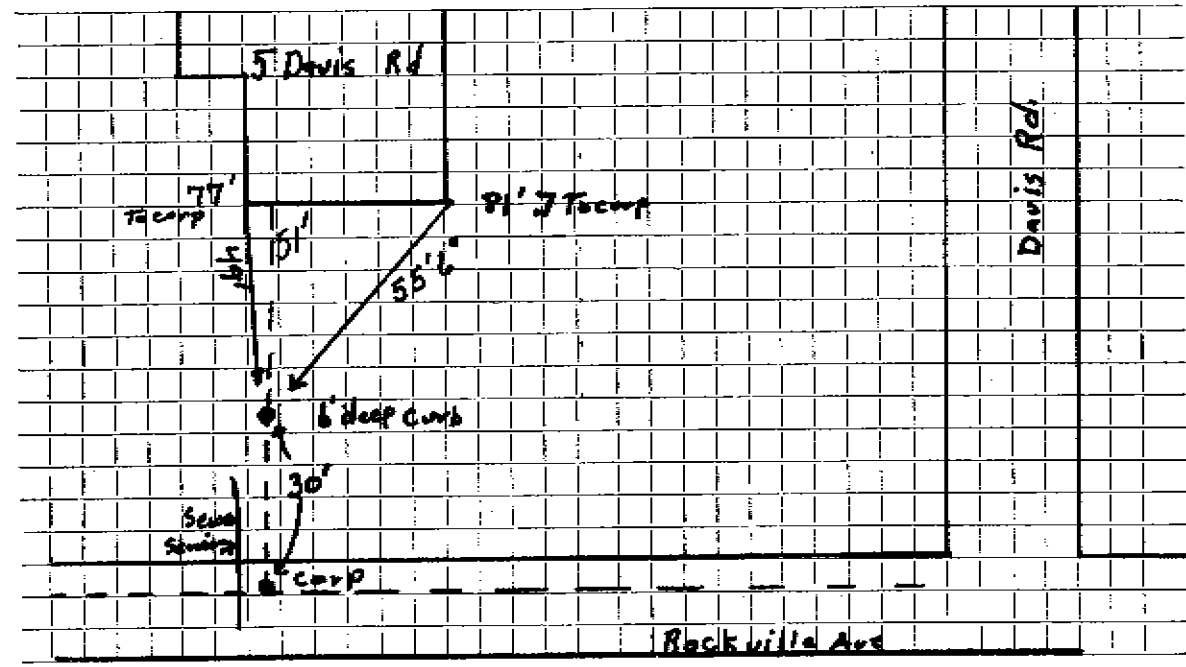

Connection made in Rockville Street. Work completed .....

Remarks: .....