

WATER SERVICE RECORD

Name Alfred J. Parece

Service No. 311 #4511

Address 1 Dawes Road

Location Lexington, Mass.

~~Repair - Renewal~~ - New Service

Com. 12-20-50

Date	Material	Amount	Total	Date	Material	Amount
Oct. 14, '50	Labor	2 70	2 70			
	10% Overhead		27			
	65' - 3/4" Copper Tubing @.31	20 15			No Charge	68 24
	1 - 3/4" C x 1/2" I.W.H. S&W	3 76		Oct. 14, '50	Labor	13 02
	1 - 3/4" C x 3/4" C Union (3pts)	1 61			33' - 3/4" Copper Tubing @.31	10 23
	Littlefield Shovel 2 hrs. @ 7.00	14 00			1 - 3/4" C Corp-cock	3 60
	Trucking 1 hr. @.75	75			1 - 3/4" C x 3/4" C Curb-cock	4 40
	Patching 25 x 3	25 00			1 - Box & Rod	4 44
			68 24		1 - 1/2" Offset Tail Piece	42
					1 - 1/2" Straight Tail Piece	42
					Littlefield Shovel 2 2/3 hrs. @7.00	18 67
					Trucking 1 hr. @.75	75
						<u>55 95</u>

DATE _____

TOWN OF LEXINGTON — BOARD OF PUBLIC WORKS
WATER DIVISION

Sketch of Service Here

A large grid of graph paper, consisting of approximately 20 columns and 25 rows of small squares, intended for sketching service details.

Connection made in Street. Work completed


Remarks:

.....
.....

DATE _____

TOWN OF LEXINGTON — BOARD OF PUBLIC WORKS
WATER DIVISION

Sketch of Service Here

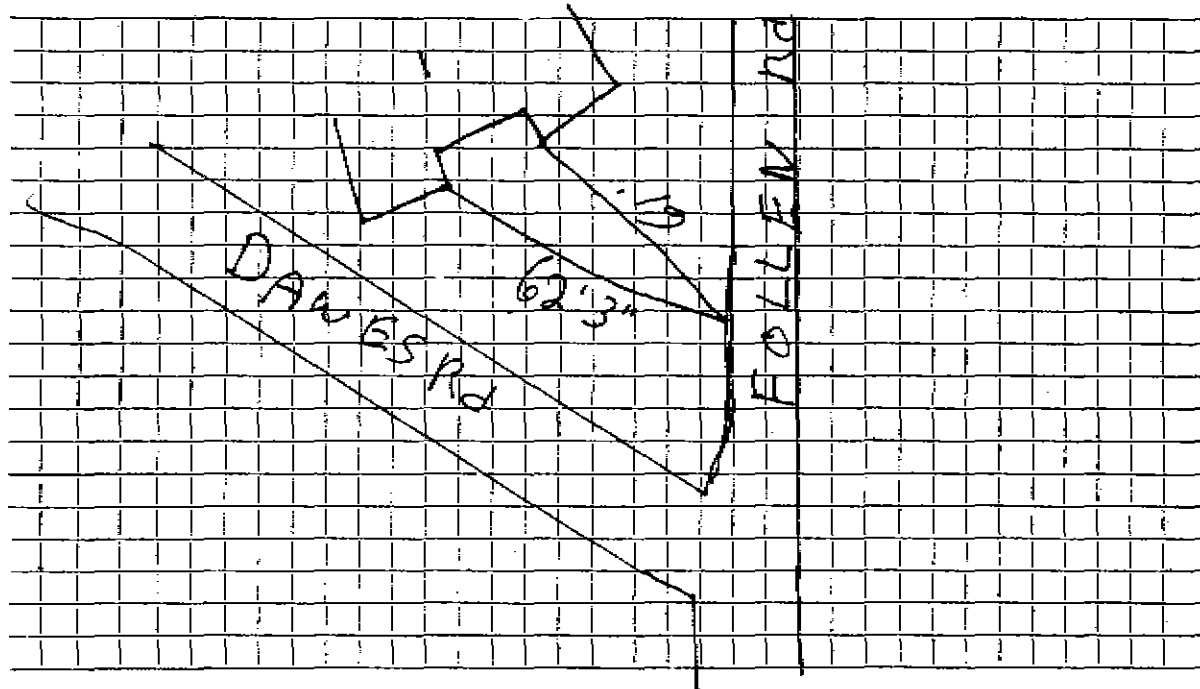

Connection made in Street. Work completed

Remarks:
.....
.....