

WATER SERVICE RECORD

Name Stanley Phalen

Service No. 104

Address 11 Dawes Road

Location

~~Repair - General~~ - New Service

Comm 9-24-56


Date	Material	Amount	Total	Date	Amount
5/15/56	Labor	17 00		5-17-56	Deposit 50 00
	10% overhead	1 70	18 70	9-24-56	Paid A 16 03
	42' 3/4" Copper tubing @ .4850	20 37			NON CHARGE 6 6 03
	1 3/4 Cx 1/2 I.W.H. Stop & Waste	4 96		5/15/56	Labor 3 80
	2 1/2 hrs. Littlefield Shovel @ 8.50	21 25		22' - 3/4" Copper tubing @ .4850	10 67
	1 hr. trucking		75	1 - 3/4" C. Corp Cock	4 34
			66 03	1 - 3/4" C. Curb Cock	5 94
				1 Box & Rod	4 62
				1 - 1/2" Straight tailpiece	50
				1 - 1/2" Offset tailpiece	50
				1 1/2 hrs. Littlefield Shovel @ 8.50	12 75
				1 hr. trucking	75
					43 87

* Paid by refund on S.A.C #43

DATE _____

TOWN OF LEXINGTON — BOARD OF PUBLIC WORKS
WATER DIVISION

Sketch of Service Here

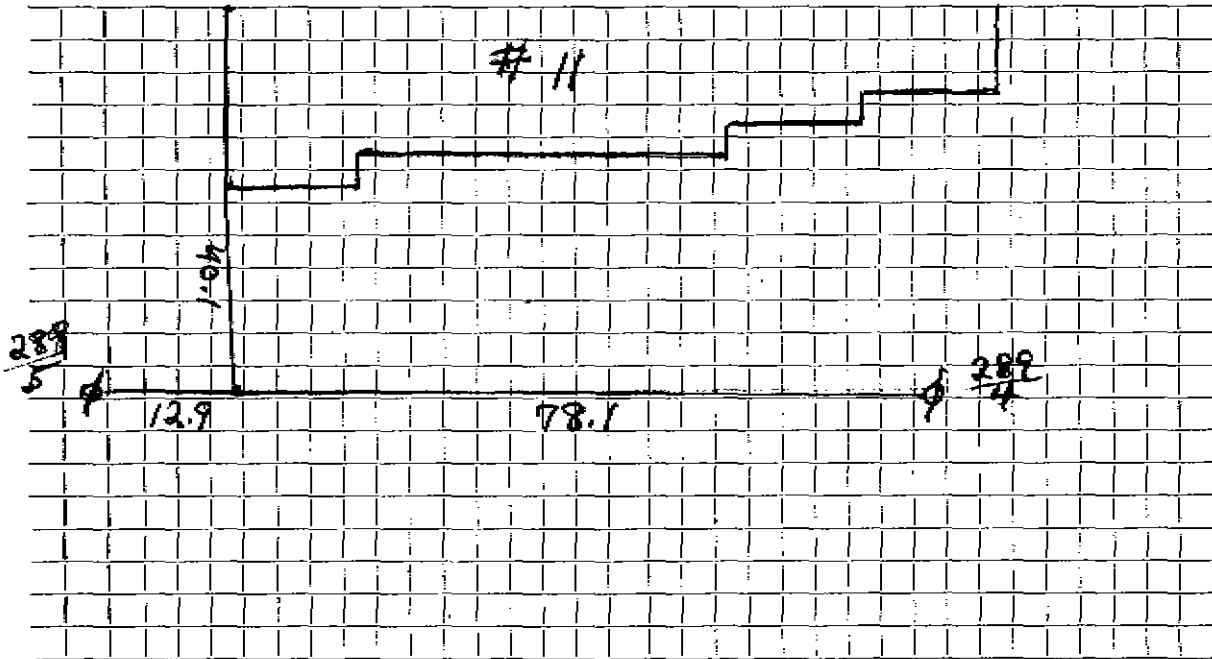

Connection made in Street. Work completed

Remarks:

.....

.....