

Name Wallace C. Kiburis

Service No. 159

#4702

Address 20 Dawes Road

#7761

Lexington, Mass.

Locatic 20 Dawes Road

Kind of Pipe

Size

Size of Main

~~Repair~~ ~~Renewal~~ New Service

Com. 9-5-50

Location

Date	Material	Amount	Total	Date	Amount
Jul. 14, '50	Labor	2 60	2 60	July 10, '50	40 00
	10% Overhead		26		
	38' - 3/4" Copper Tubing @.23		8 74		
	1 - 3/4"C x 1/2" I.W.H. S&W		3 29		
	Littlefield Shovel 1 1/2 hrs. @7.00	10 50		Jul. 14, '50	3 83
	Trucking 1 hr. @.75		75	18' - 3/4" Copper Tubing @.23	4 14
	Patching 10 x 3		10 00	1 - 3/4" C Corp-cock	3 15
			36 14	1 - 3/4"C Curb-cock	3 85
				1 - Box & Rod	3 35
				1 - 1/2" Offset Tail Piece	38
				1 - 1/2" Straight Tail Piece	38
				Littlefield Shovel 1 hr. @ 7.00	7 00
				Trucking 1 hr. @.75	75
	Labor				26 83

Deposited
No Charge

Hudley Press, Inc., Lexington

DATE _____

TOWN OF LEXINGTON—BOARD OF PUBLIC WORKS

WATER DIVISION

The undersigned applies for a supply of water at No. _____ St. and hereby agrees to comply with the rules and regulations as now, or at any future time, established by the Board of Selectmen.

Am't. of Estimate \$ _____

Owner _____


Am't. Paid \$ _____

Address _____

Builder _____

20 DAWES

Sketch of Service Here

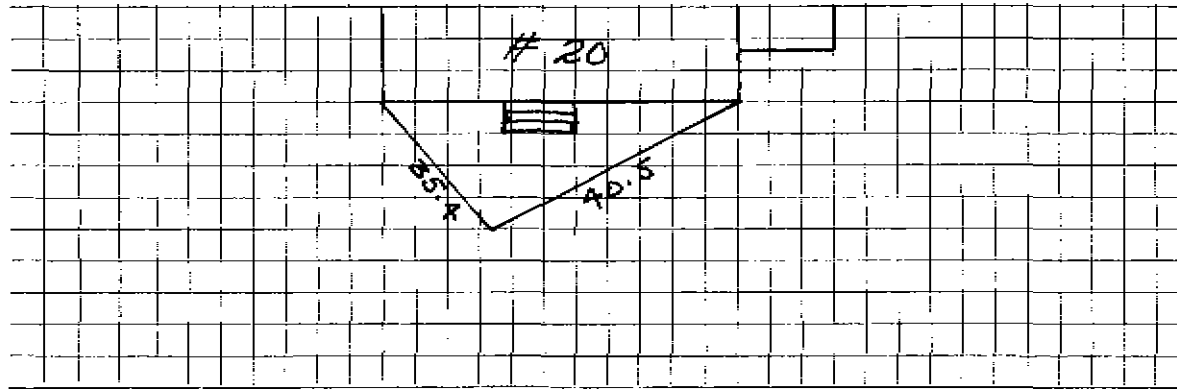

Connection made in _____ Street.

Work completed _____ 19

Remarks: