

Name A. J. Comeau
 Address 21 Dawes Road

Service No. 126

Lexington, Mass.

Location 21 Dawes Road

Kind of Pipe Size Size of Main

~~Repair~~ ~~Renovate~~ New Service Com 9-5-50

Location

Date	Material	Amount	Total	Date	Amount
Jul. 27, '50	Labor	4 90	4 90	June 10, '50	90 00
	10% Overhead		49		1 25
	72' - 3/4" Copper Tubing @.23		16 56		73 25
	1 - 3/4"C x 1/2" I.W.H. S&W		3 29	Jul. 27, '50	5 25
	1 - 3/4"C x 3/4"C Union (3pts)		1 39	27' - 3/4" Copper Tubing @.23	6 21
	Littlefield Shovel 4 hrs. @ 7.00		28 00	1 - 3/4"C Corp-cock	3 15
	Trucking 1 hr. @.75		75	2 - 3/4"C x 3/4"C Curb-cock	3 85
	Patching 18 x 3		18 00	1 - Box & Rod	3 35
			73 38	1 - 1/2" Offset Tail Piece	38
				1 - 1/2" Straight Tail Piece	38
				Littlefield Shovel 2 hrs. @ 7.00	14 00
				Trucking 1 hr. @.75	75
	Labor				<u>37 32</u>

Deported

No Charge

Hadley Press, Inc., Lexington

DATE _____

TOWN OF LEXINGTON—BOARD OF PUBLIC WORKS

WATER DIVISION

The undersigned applies for a supply of water at No. _____ St. and hereby agrees to comply with the rules and regulations as now, or at any future time, established by the Board of Selectmen.

Am't. of Estimate \$ _____


Owner _____

Am't. Paid \$ _____

Address _____

Builder _____

Sketch of Service Here

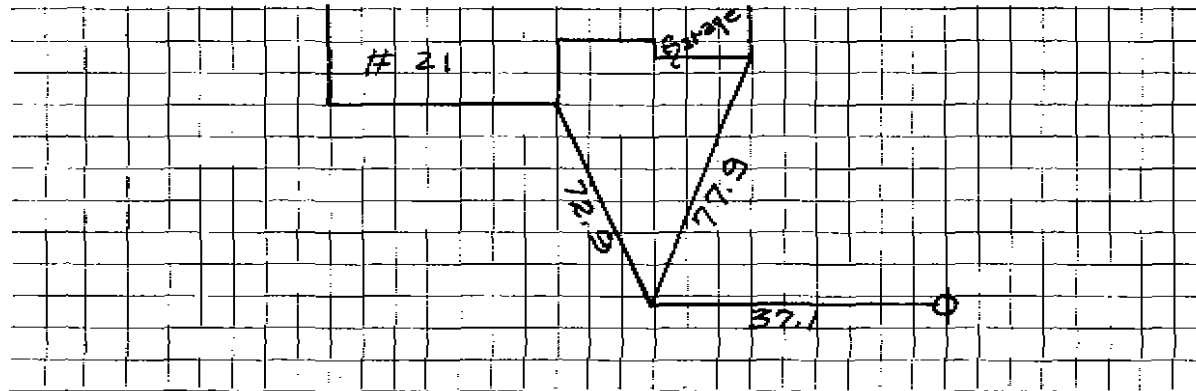

Connection made in _____ Street. Work completed _____ 19__

Remarks: