

WATER SERVICE RECORD

Name A. J. Comeau

Service No. 42

Address 25 Dawes Road

Location Lexington, Mass.


~~Repair - Renewal~~ New Service Com. 5-21-51

Date	Material	Amount	Total	Date	Material	Amount
4-3-51	Labor	6 73	6 73	<i>4-5-51</i>	<i>Plumbing</i>	<i>75 00</i>
	10% Overhead		67			
	45' - 3/4" Copper Tubing @ .36		16 20		No Charge	68 35
	1 - 3/4" C x 1/2" I.W.H. S&W		4 00	4-5-51	Labor	6 73
	Littlefield Shovel 3 hrs. @ 7.00		21 00		28' - 3/4" Copper Tubing @ .36	10 08
	Trucking 1 hr. @ .75		75		1 - 3/4" C Corp-cock	4 33
	Patching 19 x 3		19 00		1 - 3/4" C x 3/4" C Curb-cock	4 67
			68 35		1 - Box & Rod	4 68
					1 - 1/2" Offset Tail Piece	50
					1 - 3/4" Straight Tail Piece	50
					Littlefield Shovel 2 hrs. @ 7.00	14 00
					Trucking 1 hr. @ .75	75
						46 24

DATE _____

TOWN OF LEXINGTON — BOARD OF PUBLIC WORKS
WATER DIVISION

Sketch of Service Here

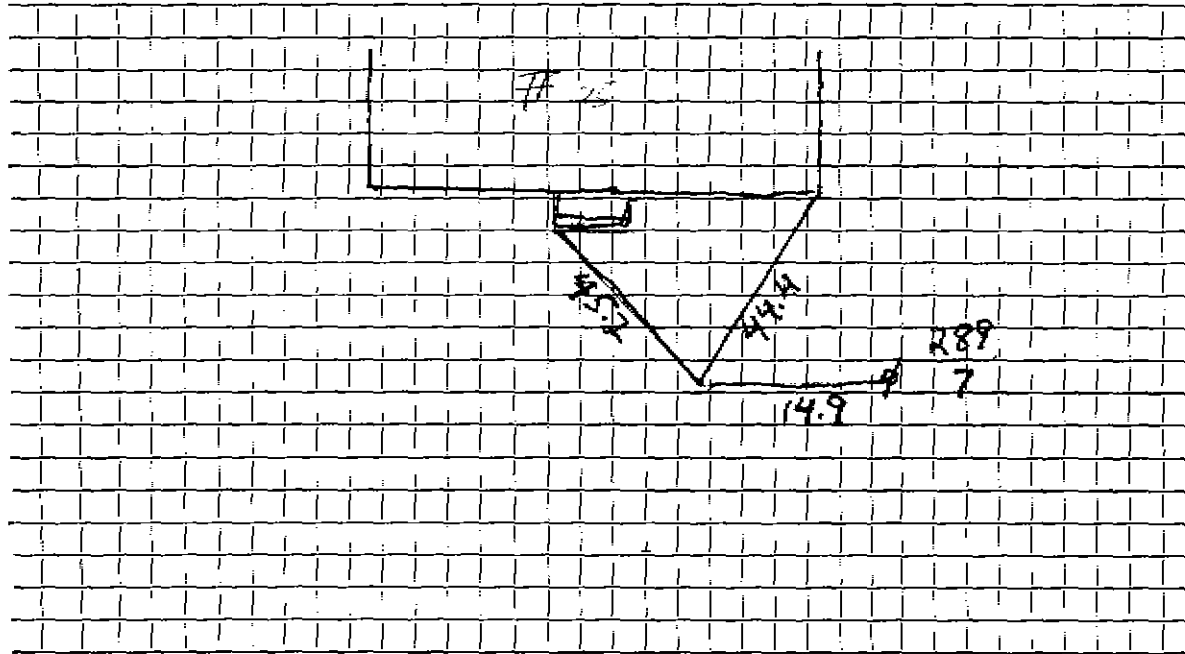

Connection made in Street. Work completed

Remarks:
.....
.....