

WATER SERVICE RECORD

Name A. J. Comeau

Service No. 311

Address 29 Dawes Road

# 7038

Location

~~Repair~~ ~~Renewal~~ - New Service

*Cam. 12-31-51*


Date	Material	Amount	Total	Date	Material	Amount
11-28-51	Labor	3 81	3 81	11-24-51	Deposited	60 00
	10% Overhead		38	12-31-51	Pre-funded	(4 13)
	55'-3/4" Copper Tubing @.326	17 93				55 87
	1-3/4" Cx 1/2" I.W.H. S&W	4 00			No Charge	
	1 Hr. Trucking		75	11-28-51	Labor	5 53
	2 Hr. Littlefield Shovel @7.00	14 00	14 00		30'-3/4" Copper Tubing @.326	9 78
	Patching 15x3		15 00		1-3/4" C Corp Cock	4 33
	Total		55 87		1-3/4" Cx 3/4" C Curb-Cock	4 07
					1 Box & Rod	4 68
					1-Offset Tail Piece	50
					1-1/2" Straight Tail Piece	50
					3 Hr. Littlefield Shovel 7.00	21 00
					1 Hr Trucking	75
					Total	51 74

DATE \_\_\_\_\_

# TOWN OF LEXINGTON — BOARD OF PUBLIC WORKS

## WATER DIVISION

Sketch of Service Here

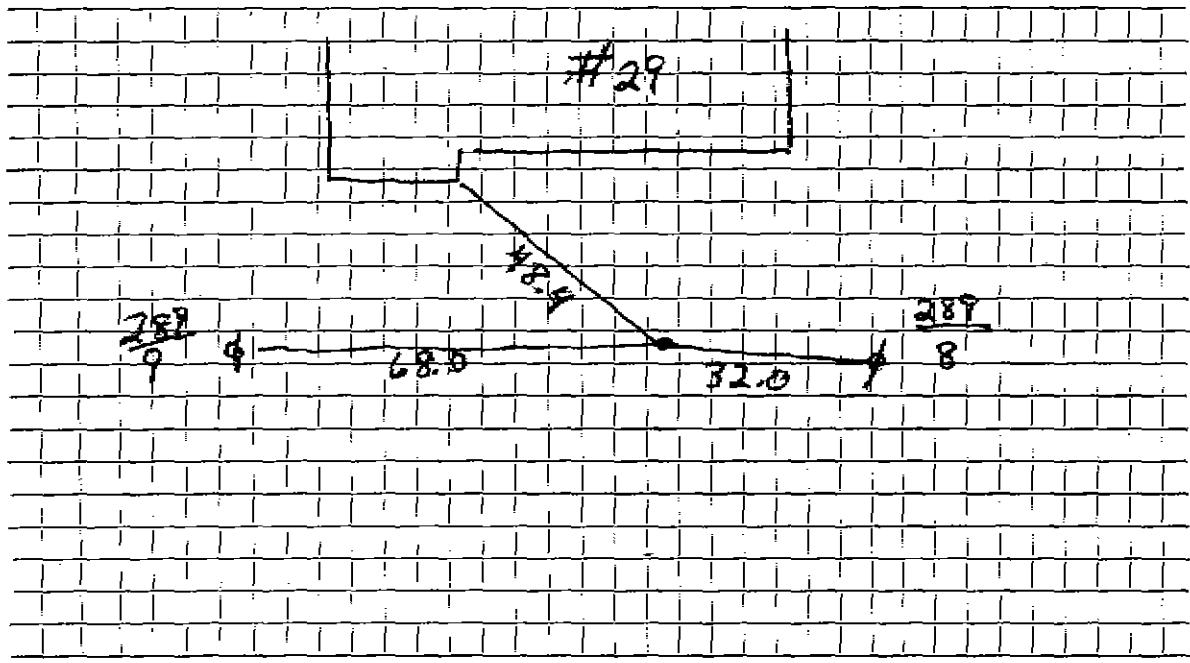

Connection made in ..... Street. Work completed .....

Remarks: .....  
.....  
.....