

Name R. J. Rideout

Service No.

Com. 9-9-46
6 8103
2057

Address 7 Sherman Court

Woburn, Mass.

Location 1 Dee Road

Kind of Pipe

Size

Size of Main

Repair—Renewal—New Service

Location

Date	Material	Amount	Total	Date	Location	Amount
May 1, '46	Labor	15 90	15 90	Mar 11 '46	Deposited	45 00
	10% Overhead		1 59	Sept 13 '46	Refunded	8 29
	39' - 3/4" Copper Tubing		7 07		Non-Charge	36 13
	1-3/4" C. x 3/4" I.Y. Stop & Waste		2 82	May 1, '46	Labor	5 00
	Patching 8 x 3		8 00	12' - 3/4" Copper Tubing		2 18
	Trucking 1 hr. @ .75		75	1 - 3/4" C. Corp-cock		2 70
			<u>36 13</u>	1 - 3/4" C. Curb-cock		3 30
				1 - Box & Rod		1 65
				1 - 3/4" Straight Tail Piece		90
				1 - 3/4" Offset Tail Piece		90
				XXXXXXXXXXXXXXXXXXXX		
				Trucking 1 hr. @ .75		75
	Labor					<u>17 38</u>

DATE _____

TOWN OF LEXINGTON—BOARD OF PUBLIC WORKS

WATER DIVISION

The undersigned applies for a supply of water at No. _____ St. and hereby agrees to comply with the rules and regulations as now, or at any future time, established by the Board of Selectmen.


Am't. of Estimate \$ _____

Owner _____

Am't. Paid \$ _____

Address _____

Builder _____

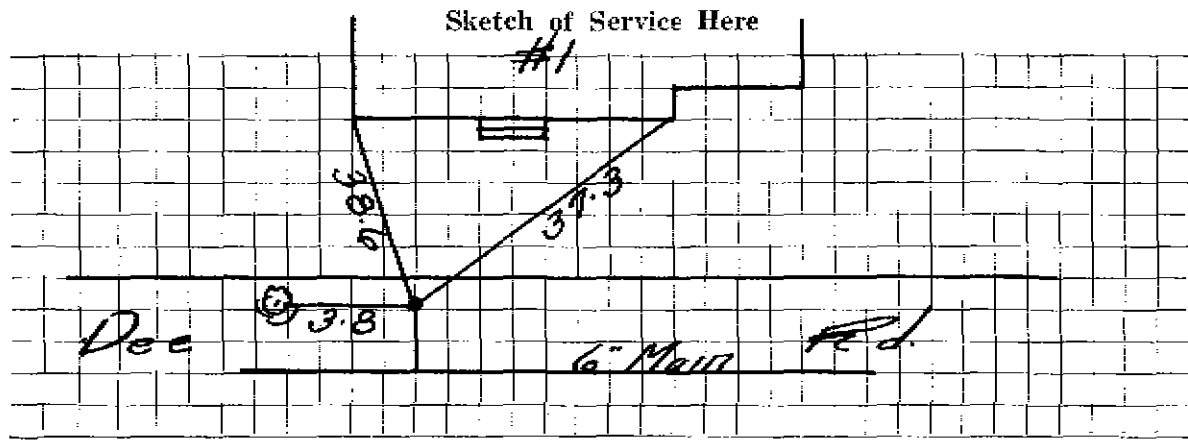

Connection made in _____ Street. Work completed _____ 19__

Remarks: