

Name

Service No. 715
#4991

Address

Location 11 Dec Rd.

Kind of Pipe

Size

Size of Main

Repair—Renewal—New Service

Location

Date

Material

Amount

Total

Date

Amount

Checked
7-25-95

Outside

3/4 Copper

Labor

TOWN OF LEXINGTON - BOARD OF PUBLIC WORKS

WATER DIVISION

The undersigned applies for a supply of water at No. _____ St. and hereby agrees to comply with the rules and regulations as now, or at any future time, established by the Board of Selectmen.

Am't. of Estimate \$ _____


Owner J. Saunders.

Am't. Paid \$ _____

Address 11 Dee Rd.

Builder _____

Sketch of Service Here

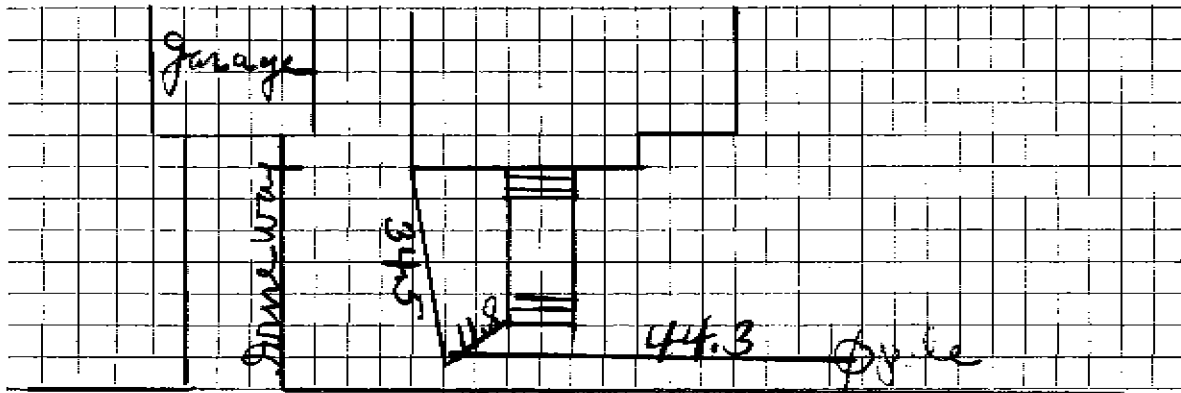

Connection made in Dee Rd. Street.

Work completed _____ 19

Remarks: