

Name Ruth J. Rideout

Address 7 Sherman Court

Woburn, Mass.

Service No. ^{Conn. 7-9-46} 3106

7408

Location 16 Dee Road

Kind of Pipe

Size

Size of Main

~~Repair~~ ~~Renewal~~ - New Service

Location

Date	Material	Amount	Total	Date	Amount
May 1, '46	Labor	19 00	19 00	May 11 '46	40 00
	10% Overhead		1 90	Sept 13 '46	7 23
	43' - 3/4" Copper Tubing		7 80		32 27
	1 - 3/4" C x 1" I.Y. Stop & Waste		2 32	May 1, '46	6 30
	Trucking 1 hr. @ .75		75	22' - 3/4" Copper Tubing	3 99
			32 27	1 - 3/4" C. Corp-cock	2 70
				1 - 3/4" C. Curb-cock	3 30
				1 - 3/4" C. Union (3 parts)	1 04
				1 - Box & Rod	1 65
				1 - 3/4" Straight Tail Piece	90
				1 - 3/4" Offset Tail Piece	90
				Trucking 1 hr. @ .75	75
	Labor				21 53

Hudley Press, Inc., Lexington

TOWN OF LEXINGTON—BOARD OF PUBLIC WORKS

WATER DIVISION

The undersigned applies for a supply of water at No. _____ St. and hereby agrees to comply with the rules and regulations as now, or at any future time, established by the Board of Selectmen.

Am't. of Estimate \$ _____


Owner _____

Am't. Paid \$ _____

Address _____

Builder _____

Sketch of Service Here

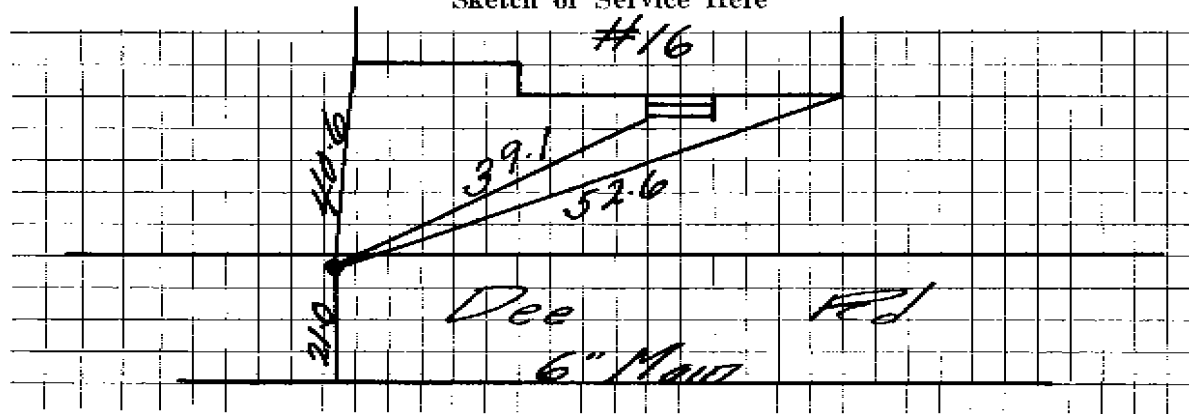

Connection made in _____ Street.

Work completed _____ 19__

Remarks: