

Name Ruth J. Rideout
 #3 Dee Rd.
 Address (7 Sherman Court owner)

Service No.

Com. 9-9-46
 9 3104
 #5067

Woburn, Mass.

Location 3 Dee Road

Kind of Pipe

Size

Size of Main

~~Repair - Renewal~~ - New Service

Location

Date	Material	Amount	Total	Date	Amount
Mar. 15, '46	Labor	16 82		Mar. 11, '46	35 00
16 '46	"	3 77	20 29	Sept 13, '46	2 83
	10% Overhead		2 04		82 17
	34' - 1/2" Copper Tubing		6 17	Mar. 15, '46	11 80
	1-3/4" C.x3/4" C.W.H. Stop & Waste		2 82	14' - 3/4" Copper Tubing	2 54
	1 hr. Trucking @ .75		75	1 - 3/4" C. Corp-cock	2 70
			32 17	1 - 3/4" C x 1/2" C. Curb-cock	3 30
				1 Box & Rod	1 65
				2 - 3/4" Straight Tail Piece	90
				1 - 3/4" Offset Tail Piece	90
				Compressor 1 hr. :1.75	1 75
				Trucking 1 hr. @ .75	75
	Labor				36 29

Deposited
Refunded
 Non-Charge

Hadley Press, Inc., Lexington

DATE _____

TOWN OF LEXINGTON - BOARD OF PUBLIC WORKS

WATER DIVISION

The undersigned applies for a supply of water at No. _____ St. and hereby agrees to comply with the rules and regulations as now, or at any future time, established by the Board of Selectmen.


Am't. of Estimate \$ _____

Owner _____

Am't. Paid \$ _____

Address _____

Builder _____

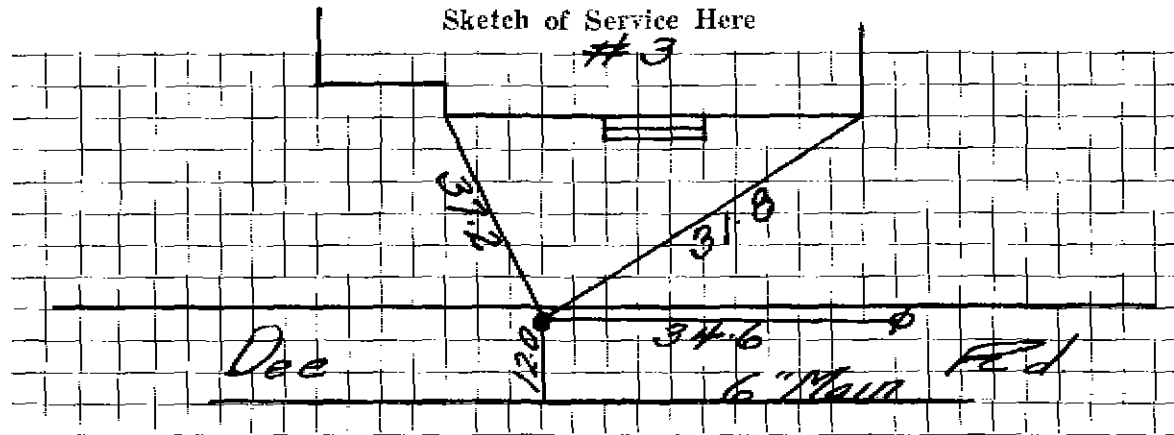

Connection made in _____ Street. Work completed _____ 19

Remarks: