

Name Otis S. Brown

Service No.

Address 7 Dee Road

Lexington, Mass.

Location 7 Dee Road

Kind of Pipe

Size

Size of Main

~~Repair~~—Renewal—~~New Service~~

Location

Date	Material	Amount	Total	Date	Amount
Nov. 5, '47	Labor	13 90	13 90		
	26' - 3/4" Cooper Tubing @.26		6 76		
	1 - 3/4" C. Adapter		1 32		
	1 - 3/4" C x 3/4" C Curb-cock		3 68		
	Trucking 1 hr. @.75		75		
			<hr/>		
			26 41		
3-28-01	35.6' 1" COPPER 1 COP/IRON ADAPT. INSTALLED BY MURPHY CO. KS.				
	Labor				

DATE _____

TOWN OF LEXINGTON – BOARD OF PUBLIC WORKS

WATER DIVISION

The undersigned applies for a supply of water at No..... St. and hereby agrees to comply with the rules and regulations as now, or at any future time, established by the Board of Selectmen.

Am't of Estimate \$.....

Owner


Am't Paid \$.....

Address

Builder

.....

Sketch of Service Here

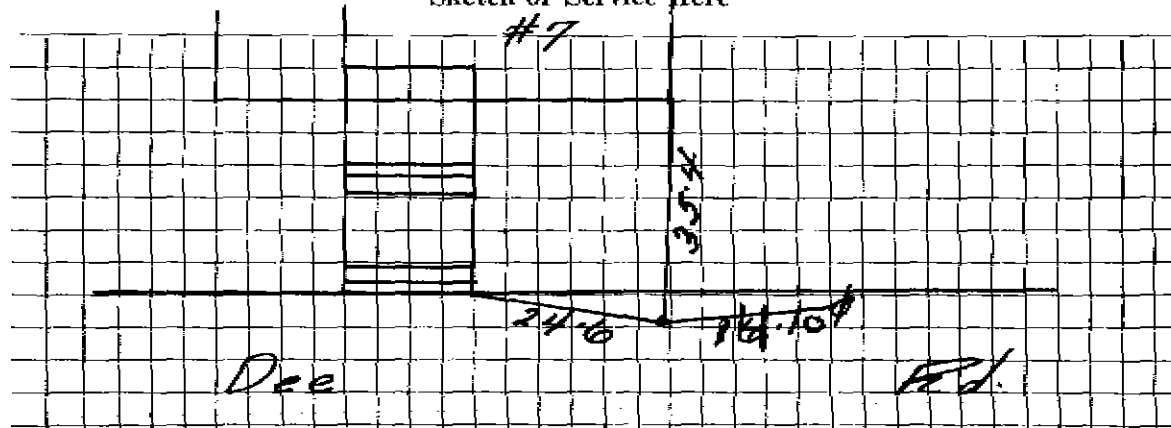

Connection made in Street.

Work completed19

Remarks: