

WATER SERVICE RECORD

Name Gilbert Harris

Service No. 223

Address 18 Deering Ave., Lexington, Mass.

7060

Location

~~Repair~~ ~~Renewal~~ - New Service

Comm. 12/31/57


Date	Material	Amount	Total	Date		Amount
11/7/57	Labor	1 76		10-10-57	Deposit	\$ 50 00
	10% Overhead	18	1 94	12-31-57	Refund	13 44
	72'-3/4" Copper Tubing @.37		26 64			\$ 36 56
	1-3/4" Cx 1/2 IWH stop & waste		4 96		Non Charge	
	1 hr. Trucking @.75		75		Labor	1 76
	1-3/4" C Union 3 part		2 27		28'-3/4" Copper Tubing @.37	10 36
			36 56		1-3/4" C Corp Cock	4 64
					1-3/4" C Curb Cock	5 94
					1 Bow & Rod	4 62
					1-1/2 straight tail piece	50
					1-1/2 offset tail piece	50
						28 32

DATE _____

TOWN OF LEXINGTON — BOARD OF PUBLIC WORKS

WATER DIVISION

Sketch of Service Here

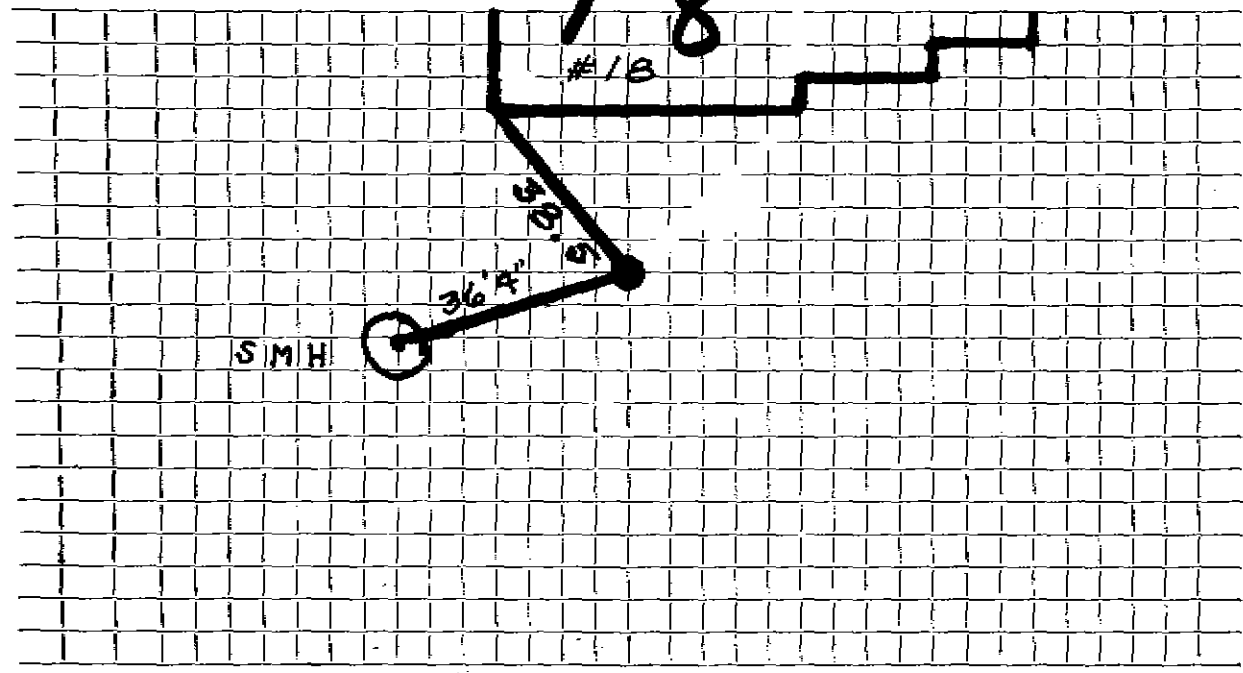

Connection made in Street. Work completed

Remarks:
.....
.....