

WATER SERVICE RECORD

3008

Name Charles H. Murray

Service No. 126

Address 19 Dearing ~~Avenue~~ Rd.

Location

~~Repair~~ ~~Renewal~~ New Service

Service was into Curb

Comm 11-24-58


Date	Material	Amount	Total	Date		Amount
7/18/58	Labor	3 70		6-22-58	Deposit	25 00
	10% Overhead	37	4 07	11-24-58	* Renewal	1 02
	36'-3/4" Copper tubing @.37	13 32			NON CHARGE	23 98
	1-3/4" C x 1/2 IWH stop & waste	5 84		9/16/57	Labor	3 71
	1 hr. Trucking @.75		75	19' - 3/4" Copper tubing		7 13
			23 98	1 3/4" C. Curb Cock		5 94
				1 3/4" C. Corp Cock		4 64
				1 Box & Rod		4 62
				1 Hr. Trucking		75
						26 79
				7/18/58-1-1/2" straight tailpiece		50
				1-1/2" offset tailpiece		50
						27 79

* Applied to 54114/15

DATE _____

TOWN OF LEXINGTON — BOARD OF PUBLIC WORKS
WATER DIVISION

Sketch of Service Here

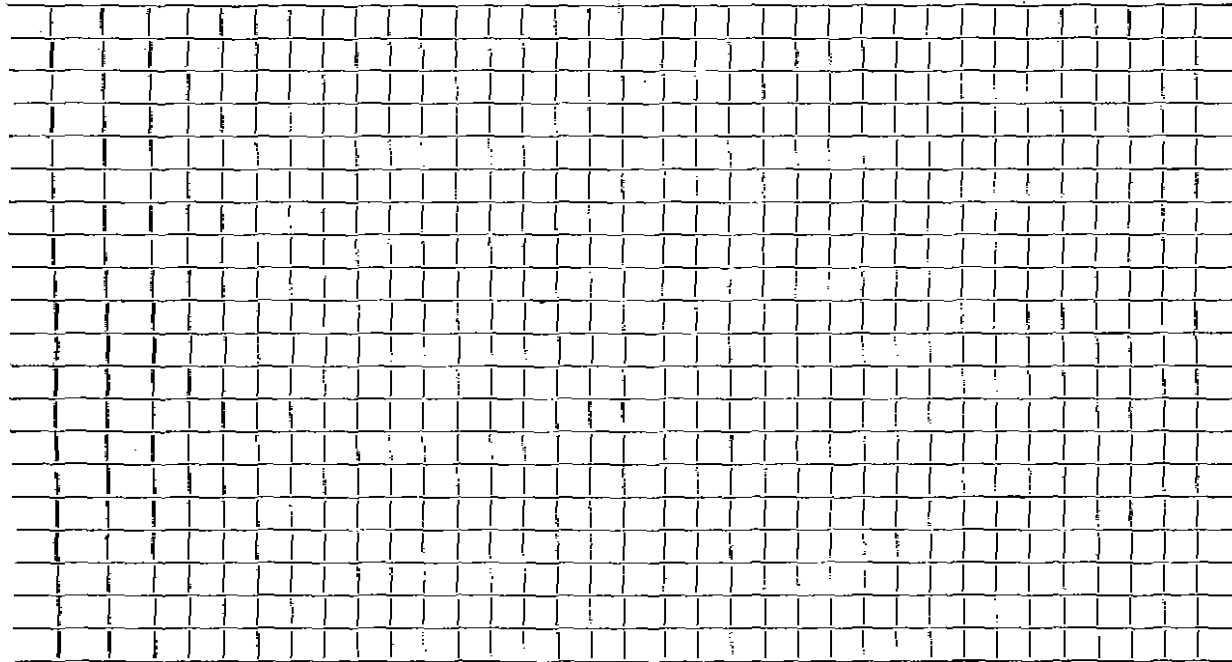

Connection made in Street. Work completed

Remarks:
.....
.....