

WATER SERVICE RECORD

Name

Service No.

Address 20 Deering Avenue

Location


Repair—Renewal—New Service

Date	Material	Amount	Total	Date	Amount
11-29-57	65' 3/4" Copper				
	1 3/4" C. X 1/2" I.W.H. Stop + Waste				NON CHARGE
	1 3/4" C. 3 Part Union			9/16/57	Labor 3 71
				19'- 3/4 "	Copper tubing 7 13
				1 3/4 "	C. Corp Cock 4 64
				1 3/4 "	C Curb Cock 5 94
				1	Box & Rod 4 62
				1 Hr.	Trucking 75
					<u>26 79</u>

DATE \_\_\_\_\_

**TOWN OF LEXINGTON — BOARD OF PUBLIC WORKS**  
**WATER DIVISION**

Sketch of Service Here

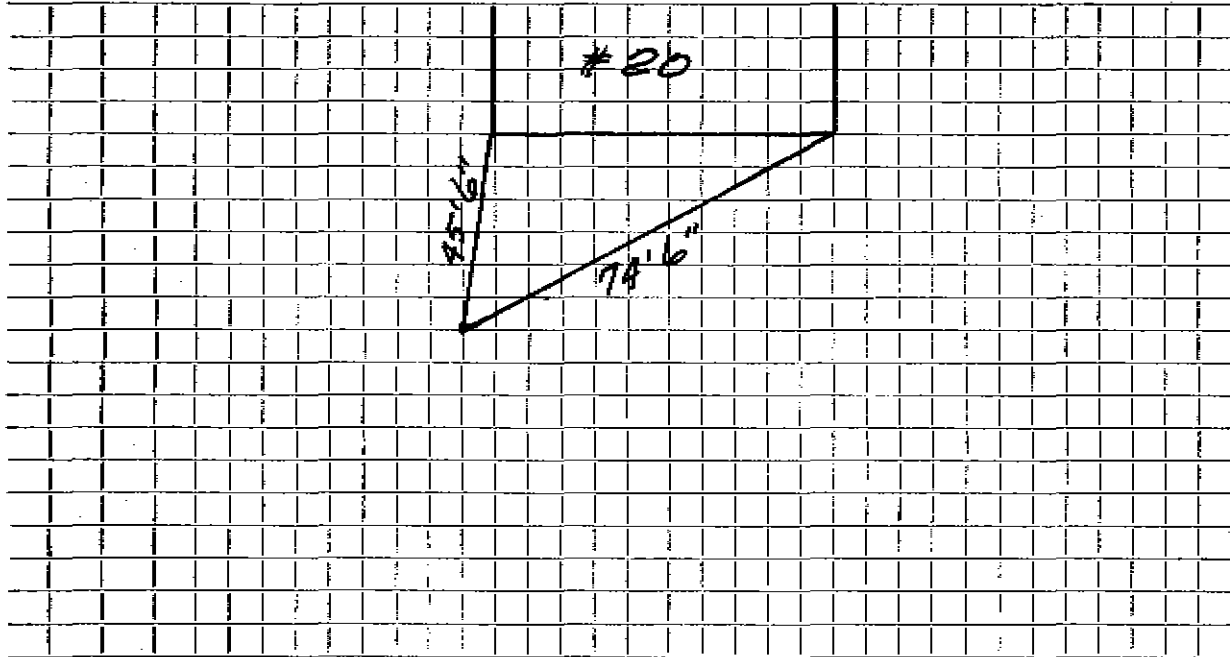

Connection made in ..... Street. Work completed .....

Remarks: .....  
.....  
.....