


DATE June 11th, 2016

TOWN OF LEXINGTON — BOARD OF PUBLIC WORKS

WATER DIVISION

Sketch of Service Here

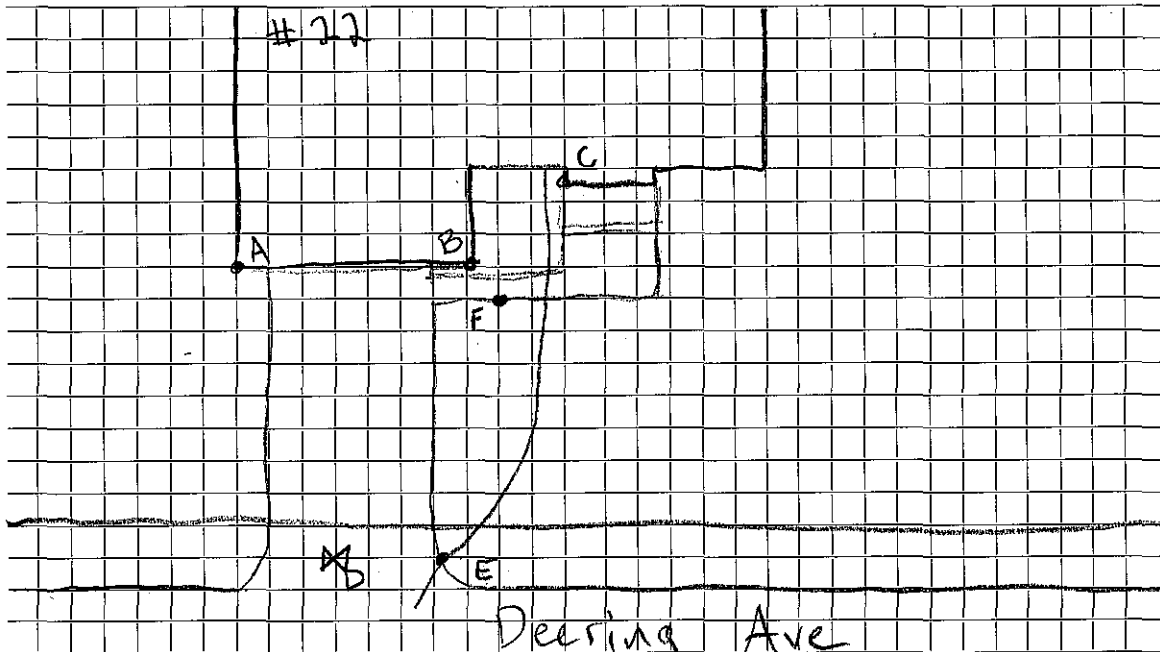

F = 22" + Cleanout
D = Ferroc 6" x 6"
E = Curb 5.5' depth

AD = 43'
BD = 42'
AE = 41.5'
BE = 40.5'
BF = 3'
CF = 16'

Connection made in # 22 Deering Avenue Street.

Work completed June 11th 2016

Remarks: