

WATER SERVICE RECORD

Name

Service No.

Address

23 Deering Avenue

Location


Repair—Renewal—New Service

Date	Material	Amount	Total	Date	Amount
9-12-57					
	40' 3/4" Copper				
	1 3/4" X 1/2" I.W.H. Stop + Waste				
					NON CHARGE
				9/17/57	Labor 3 52
				19' - 3/4"	Copper tubing 7 13
				1 3/4"	C. Corp Cock 4 64
				1 3/4"	C Curb Cock 5 94
				1	Box & Rod 4 62
					<u>25 85</u>

DATE _____

TOWN OF LEXINGTON — BOARD OF PUBLIC WORKS
WATER DIVISION

Sketch of Service Here

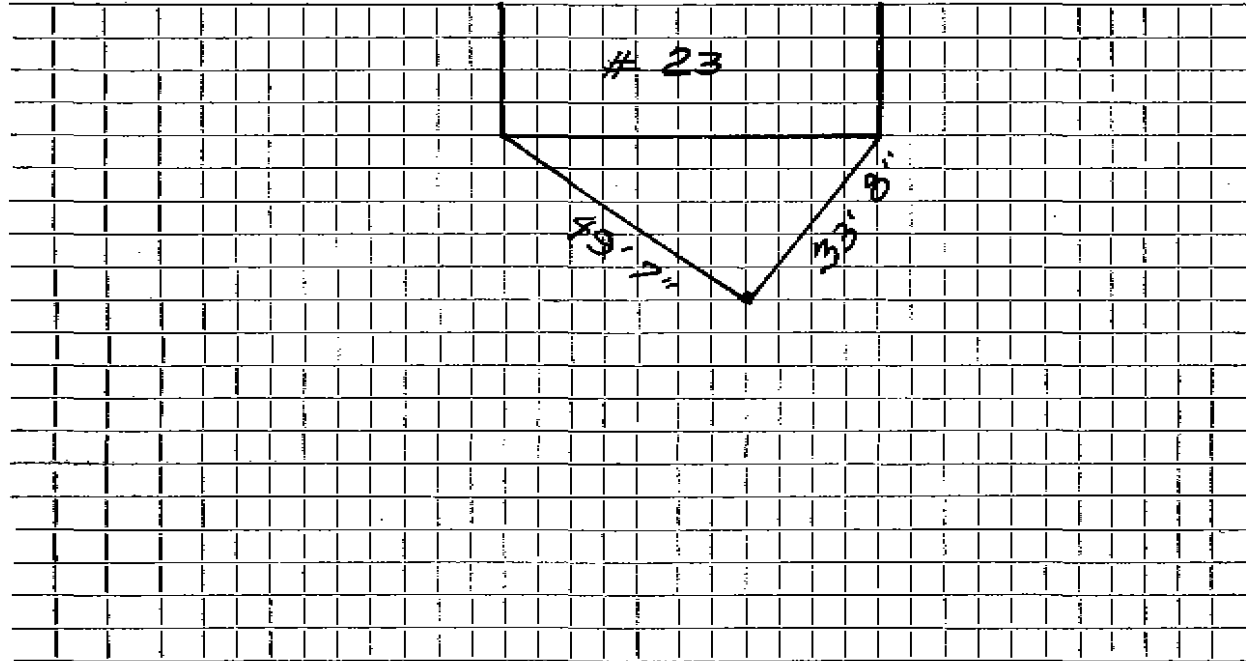

Connection made in Street. Work completed

Remarks:

.....

.....