

WATER SERVICE RECORD

#1827

Name Oakmount Realty Trust

#2995

Service No. 188

Address 24 Deering Ave.

Location

Repair—Renewal—New Service


Comm. 11-18-57

| Date | Material | Amount | Total | Date | Amount | |
|---------|--------------------------------|--------|-------|-----------------------------|------------|----------|
| 9/11/57 | Labor | 2 15 | | 8-26-57 | Deposit | \$ 25 00 |
| | 10% overhead | 22 | | 11-18-57 | Refund | 3 04 |
| | | | 2 37 | | NON CHARGE | \$ 21 96 |
| | 37' 2/3" copper tubing @.375 | 13 88 | | | labor | 5 38 |
| | 1 3/4" Cx 1/2 IWH stop & waste | 4 96 | | 37' 3/4" copper tubing .375 | 13 88 | |
| | 1 hr. trucking @.75 | 75 | | 1 3/4" C.corp cock | 4 64 | |
| | | | 21 96 | 1 3/4" C.Curb cock | 5 94 | |
| | | | | 1 box & rod | 4 62 | |
| | | | | 1 1/2 straight tail pc. | 50 | |
| | | | | 1 1/2 offset tail pc. | 50 | |
| | | | | | | 35 46 |

DATE _____

TOWN OF LEXINGTON — BOARD OF PUBLIC WORKS
WATER DIVISION

Sketch of Service Here

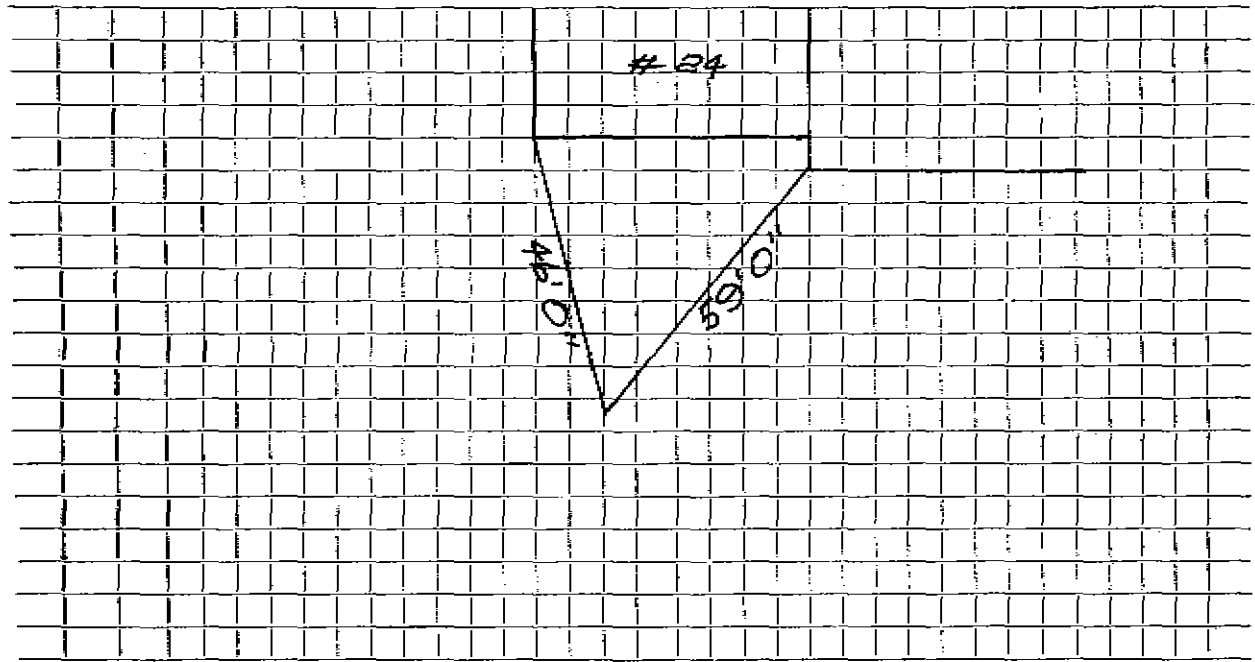

Connection made in Street. Work completed

Remarks:
.....
.....