

WATER SERVICE RECORD

3524

Name Herbert McConchie

Service No. 107

Address 26 Deering Avenue

Location

~~Repair~~ ~~General~~ New Service

Comm 11-9-59


Date	Material	Amount	Total	Date	Amount	
8-24-59	Labor	1.85		8-12-59	Deposit	.50 00
	10% O.E.	.19	2.04	11-9-59	Retained	16 77
	60' 3/4" Copper tubing @.41		24.60			33.23
1	3/4" C x 1/8" I.W.F. Stop & Waste		5.84		NON CHARGE	
1	hr. Trucking @.75		.75	1	1/8" Straight tailpiece	.50
			33.23	1	1/8" Offset tailpiece	.50
						1.00

DATE _____

TOWN OF LEXINGTON — BOARD OF PUBLIC WORKS

WATER DIVISION

Sketch of Service Here

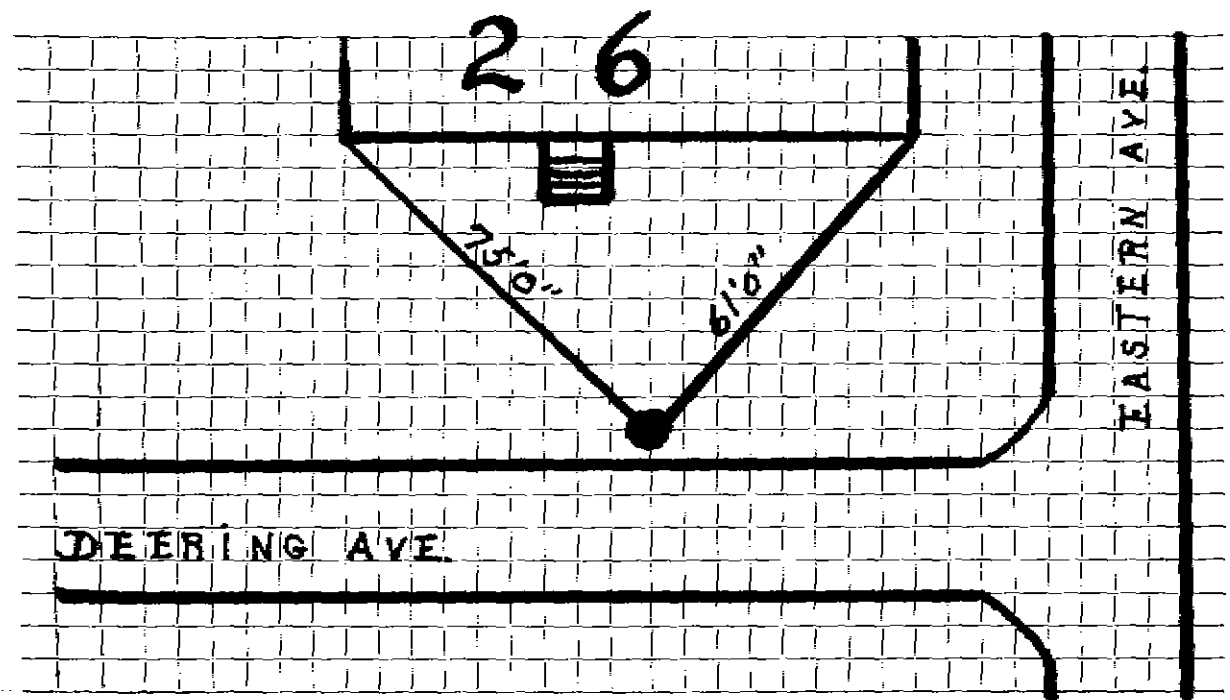

Connection made in Street. Work completed

Remarks:
.....
.....