

WATER SERVICE RECORD

Name Techbuilt, Inc.

Service No. 134

Address 12 DeMar Road

423

Location

~~Repair & Renewal~~ - New Service


Comm. 10-29-56

Date	Material	Amount	Total	Date	Curb to Main	Amount
6/21/56	Labor	1 95			NON CHARGE	
	10% overhead	20	2 15		Labor	1 95
	Owner supplied copper				8' 3/4" Coppertubing @.4850	3 88
	1 3/4 Cx 1/2 IWH Stop & Waste		4 96		1 3/4 C.Corp Cock	4 64
	1 hr trucking @ .75		75		1 3/4 C Curb Cock	5 94
			7 86		1 Box & Rod	4 62
					1 1/2 Straight tail piece	50
					1 1/2 Offset Tail piece	50
						22 03
				6-1-56	Deposit	10 00
				10-29-56	Refund	2 14
						7 86

DATE _____

TOWN OF LEXINGTON — BOARD OF PUBLIC WORKS
WATER DIVISION

Sketch of Service Here

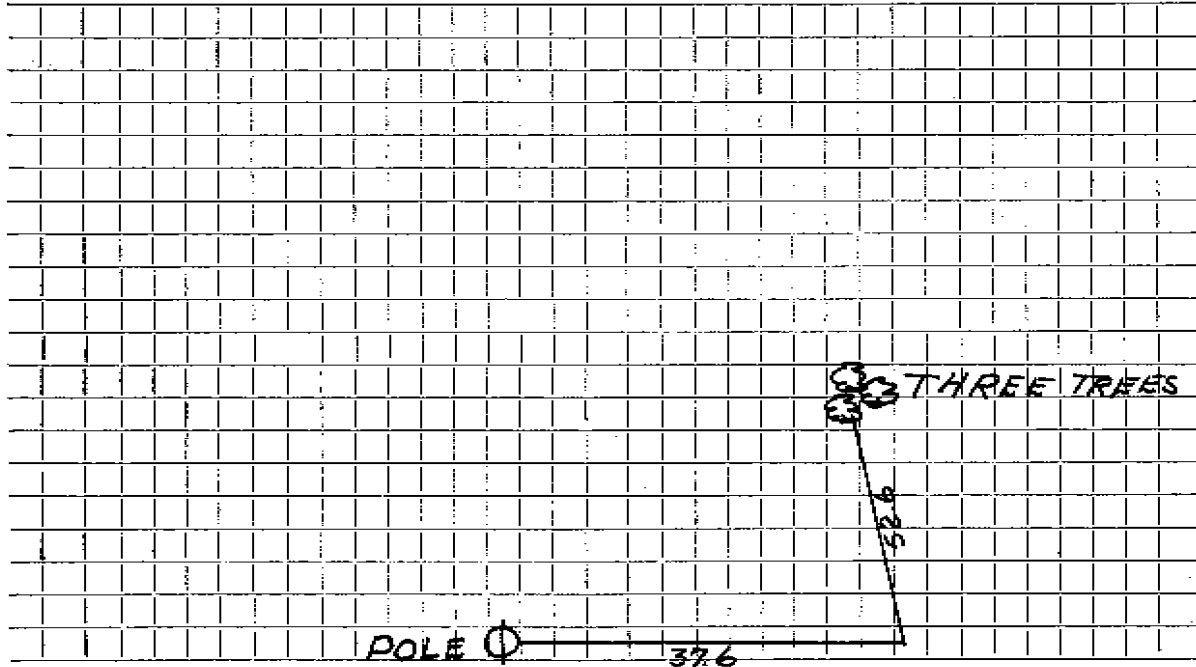

Connection made in Street. Work completed

Remarks:

.....

.....