

WATER SERVICE RECORD

Service No. 167

Name Techbuilt, Inc.

Address 16 DeMar Road

Location

~~Repair - Renewal~~ - New Service

Comm. 12-3-56


Date	Material	Amount	Total	Date	Amount	
6/21/56	Labor	1 90		6-20-56	Deposit	10 00
	10% overhead	20	2 10	12-3-56	Refund	2 94
	1 - 3/4" Cx 1/2 I.W.H. Stop & Waste		4 96		NON CHARGE	7 06
			7 06			
				Labor	1 90	
				10' - 3/4" Copper tubing @ .4850	4.85	
	(owner's copper)			1 3/4" C. Corp Cock	4 64	
				1 3/4" C. Gurb Cock	5 94	
				1 Box & Rod	4 62	
				1 - 1/2 Straight tailpiece	50	
				1 - 1/2 Offser tailpiece	50	
					<u>22 95</u>	

DATE _____

TOWN OF LEXINGTON — BOARD OF PUBLIC WORKS

WATER DIVISION

Sketch of Service Here

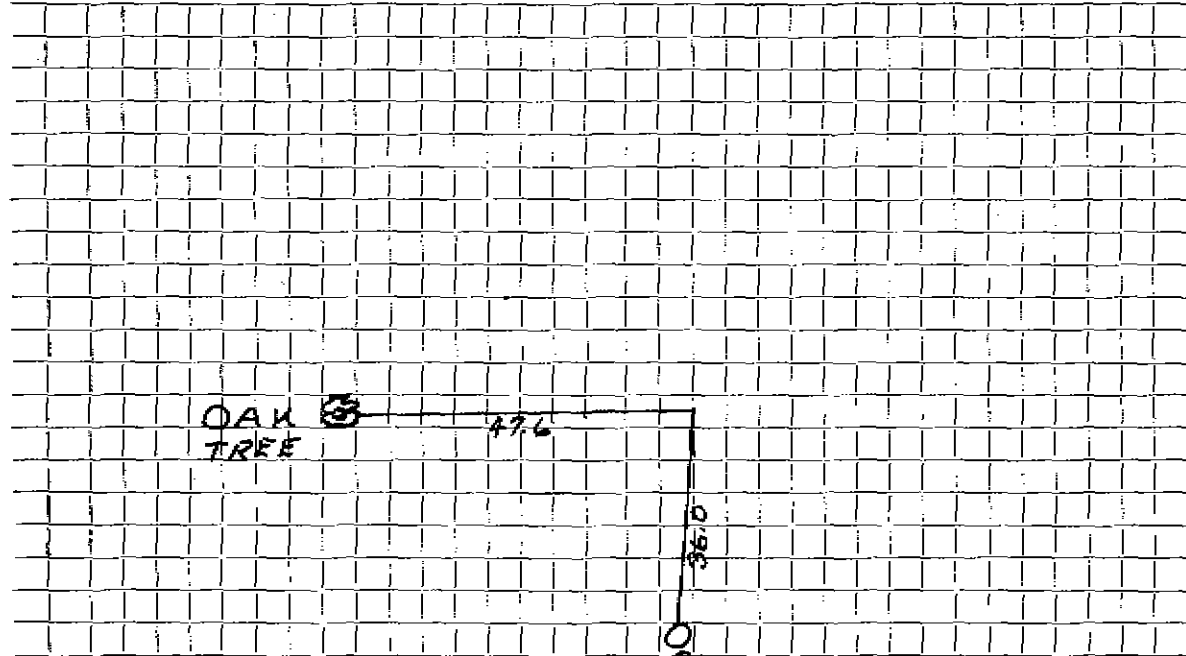

Connection made in Street. Work completed

Remarks:

.....
.....