

WATER SERVICE RECORD

#4174

Name Techbuilt, Inc.

Service No. 203

Address 19 DeMar Road

Location

~~Repair - Renewal~~ - New Service

Comm: 12-3-56


Date	Material	Amount	Total	Date	Amount
7/14/56	Labor	1 90		7-11-56	Deposit \$ 10 00
	10% overhead	20	2 10	12-3-56	Refund 2 94
	1 - 3/4Cx $\frac{1}{2}$ I.W.H. Stop & Waste		4 96		NON CHARGE 7 06
			7 06		
				Labor	1 90
				25' - 3/4" Copper tubing @ .4850	12 13
				1 - 3/4" C. Corp Cock	4 64
				1 - 3/4" C. Curb Cock	5 94
				1 Box & Rod	4 62
				1 - $\frac{1}{2}$ Straight tailpiece	50
				1 - $\frac{1}{2}$ Offset tailpiece	50
					30 23

DATE _____

TOWN OF LEXINGTON — BOARD OF PUBLIC WORKS

WATER DIVISION

Sketch of Service Here

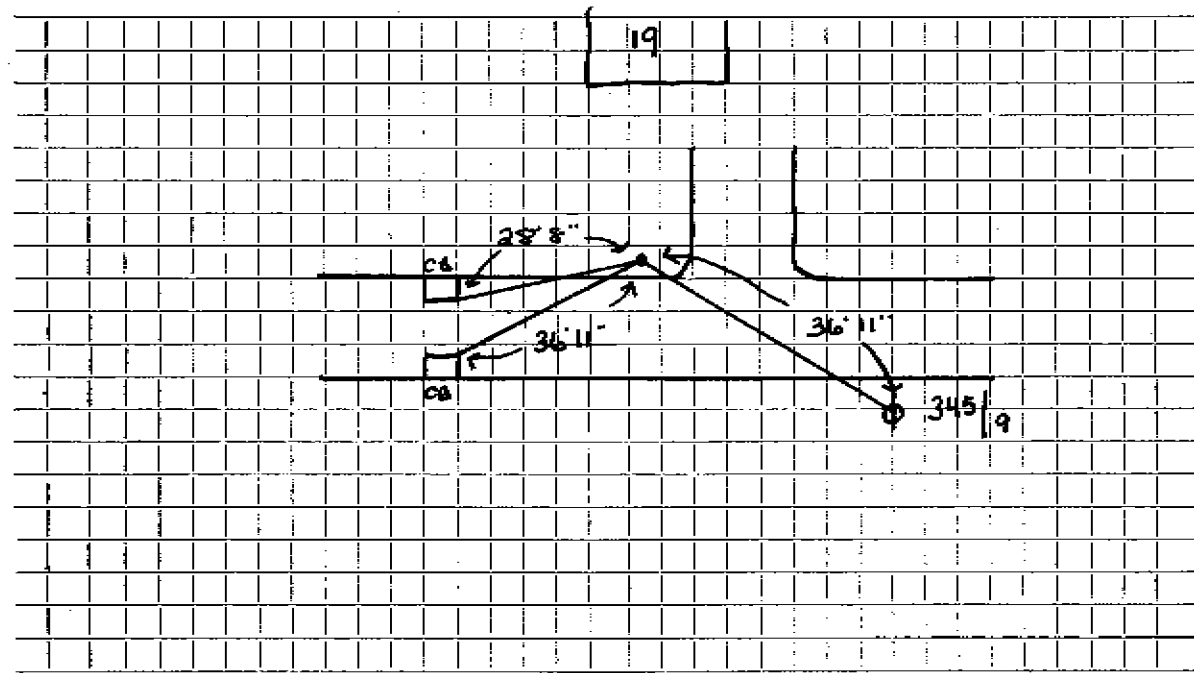

Connection made in Street. Work completed

Remarks:

.....

.....