

WATER SERVICE RECORD

#5243

Name Techbuilt, Inc.

Service No. 205

Address 21 DeMar Road

Location

~~Repair - Renewal~~ - New Service

Comm. 12-3-56


Date	Material	Amount	Total	Date	Amount
7/14/56	Labor	1 90		7-11-56	Deposit \$ 10 00
	10% overhead	20	2 10	12-3-56	Refund 2 94
	1 - 3/4" C x 1/2 I.W.H. Stop & Waste		4 96		NON CHARGE 7 06
			7 06		
				Labor	1 90
				25' - 3/4" Copper tubing @ .4850	12 13
				1 - 3/4" C. Corp Cock	4 64
				1 - 3/4" C. Curb Cock	5 94
				1 Box & Rod	4 62
				1 - 1/2 Straight tailpiece	50
				1 - 1/2 Offset tailpiece	50
					<u>30 23</u>

DATE \_\_\_\_\_

TOWN OF LEXINGTON — BOARD OF PUBLIC WORKS

WATER DIVISION

Sketch of Service Here

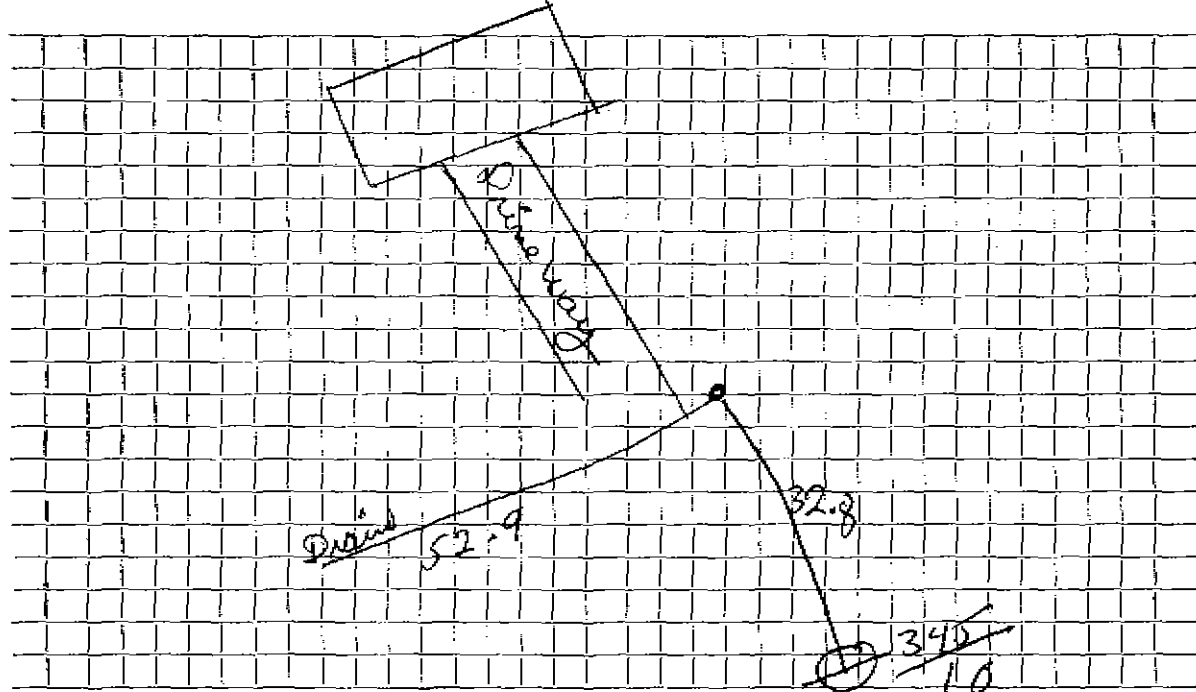

Connection made in ..... Street. Work completed .....

Remarks: .....

25 1/4" Copper Outside