


DATE 23-6-59

TOWN OF LEXINGTON — BOARD OF PUBLIC WORKS

WATER DIVISION

Sketch of Service Here

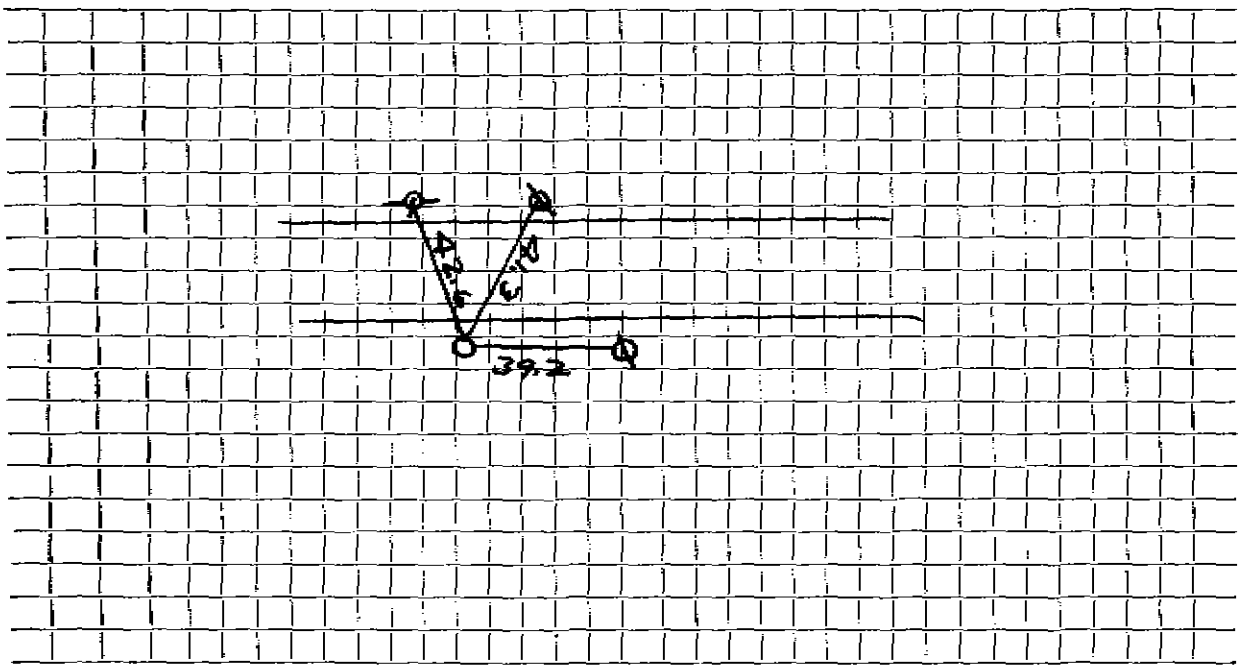

Connection made in ... DEMAR RD. ... Street. Work completed

Remarks:
.....
.....