




DATE 23-6-59

TOWN OF LEXINGTON — BOARD OF PUBLIC WORKS

WATER DIVISION

Sketch of Service Here

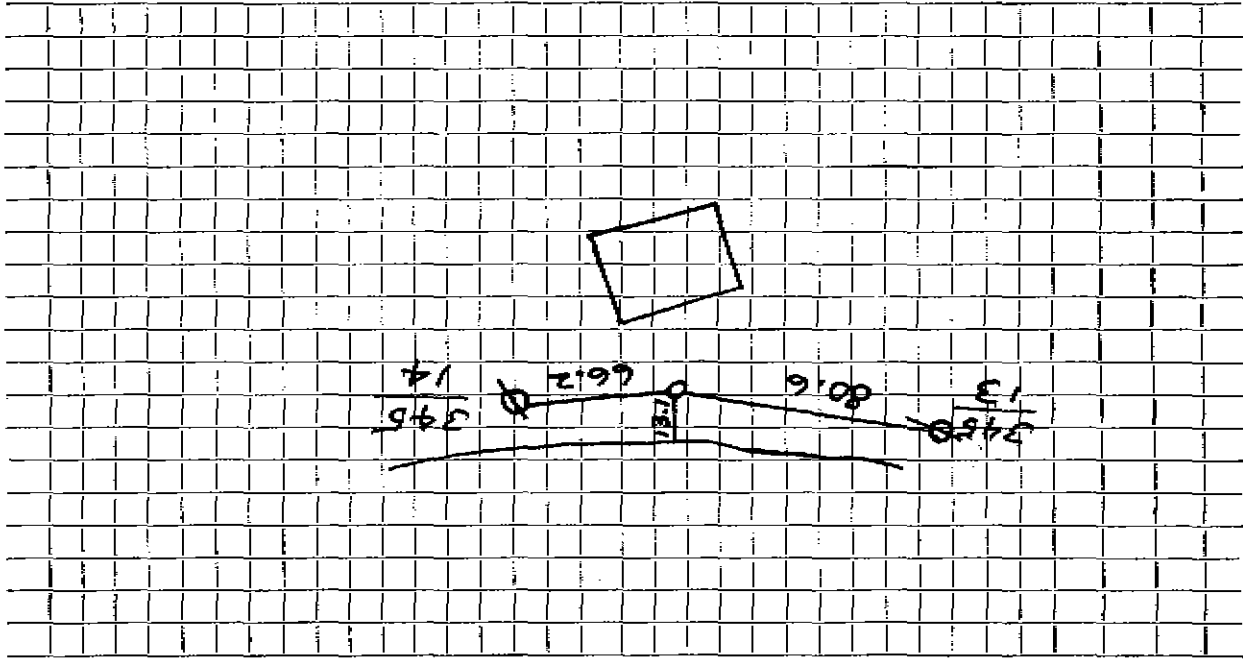

Work completed

Street

DEMARE RD.

Connection made in

Remarks: