

WATER SERVICE RECORD

Service No. 263

Name Leeland Construction Company

Address 27 DeMar Rd., Lexington, Mass.

Location

~~Repair-Replace~~ - New Service

Service was into Curb


Comm. 12/31/57

Date	Material	Amount	Total	Date	Amount
11/15/57	Labor	3 52		11-13-57	Deposit \$ 125 00
	10% Overhead	35	3 87	12-31-57	Refund 59 08
	140'-3/4" Copper Tubing @ .37		51 80		\$ 65 92
	1-3/4" CW 1/2 IWHS stop & waste		4 96		Non Charge
	2-3/4"-3 part union @ 2.27		4 54		1-1/2 straight tail piece 50
	1 hr. Trucking @ .75		75		1-1/2 offset tail piece 50
			65 92		1 00

DATE 23-6-59

TOWN OF LEXINGTON — BOARD OF PUBLIC WORKS
WATER DIVISION

Sketch of Service Here

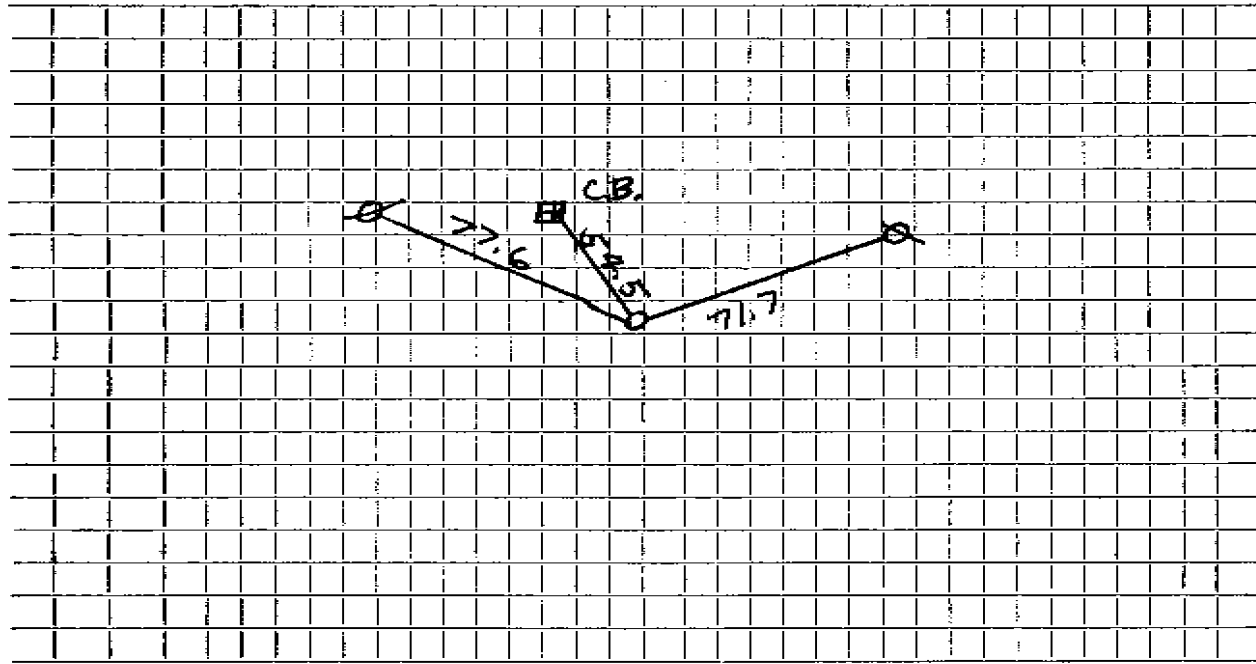

Connection made in DEMAR RD. Street. Work completed

Remarks:
.....
.....