

WATER SERVICE RECORD

Name Sterling Builders Corp.

Service No. 92

Address 28 DeMar Road

Location

~~XXXXX~~ New Service

Conn 6-11-59


Date	Material	Amount	Total	Date	Amount
5-29-59	Labor	3.54		<i>5/14/59</i>	<i>Deposit</i> 10.00
	10% O.H.	.35	3.89	<i>7/14/59</i>	<i>Paid</i> 2.81
82	3/4" Copper tubing @.3666		30.06		<i>42.81</i>
1	3/4" C x 1/2 I.W.H. Stop & Waste		5.84		NON CHARGE
1	3/4" C 3 part union		2.27	1	1/2 Straight tailpiece .50
1	hr. Trucking @.75		.75	1	1/2 Offset tailpiece .50
			<u>42.81</u>		<u>1.00</u>

Bill sent 6-22-59 2.81

DATE _____

TOWN OF LEXINGTON — BOARD OF PUBLIC WORKS
WATER DIVISION

Sketch of Service Here

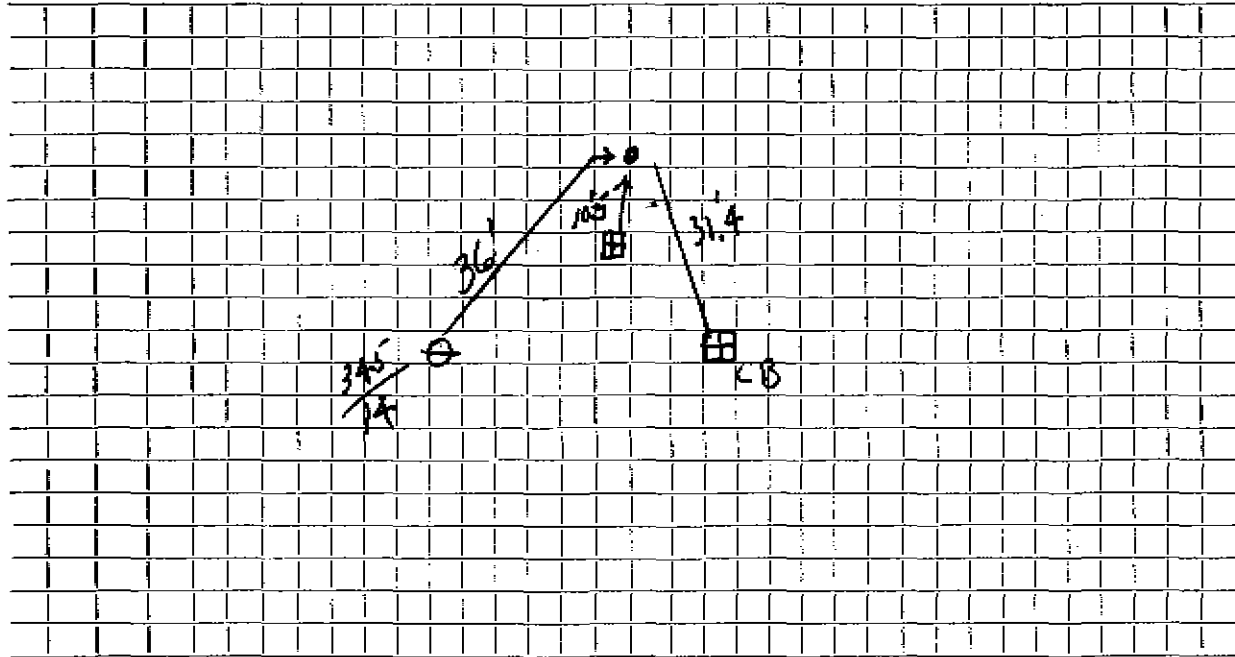

Connection made in Street. Work completed

Remarks:
.....
.....