

## WATER SERVICE RECORD

Name Techbuilt, Inc.

Service No. 136

Address 7 DeMar Road

#7093

Location

~~Repair - Annual~~ - New Service

Comm. 10-29-56


Date	Material	Amount	Total	Date	Curb to Main	Amount
7/ 56	Labor	1 95			NON CHARGE	
	10% overhead	20	2 15		Labor	1 95
	Owner supplied copper				24" 3/4" Coppertubing@.4850	11 64
	1 3/4" Cx 1/2 I.W.H. Stop & Waste		4 96		1 3/4" C. Corp Cock	4 64
	1 hr trucking @.75		75		1 3/4" Curb Cock	5 94
			7 86		1 Box & Red	4 62
					1 1/2" straight tail pc.	50
					1 1/2" offset tail pc.	50
						29 79
					6-1-56 Deposit	10 00
					10-29-56 Refund	2 14
						7 86

DATE 23-6-59

TOWN OF LEXINGTON — BOARD OF PUBLIC WORKS

**WATER DIVISION**

Sketch of Service Here

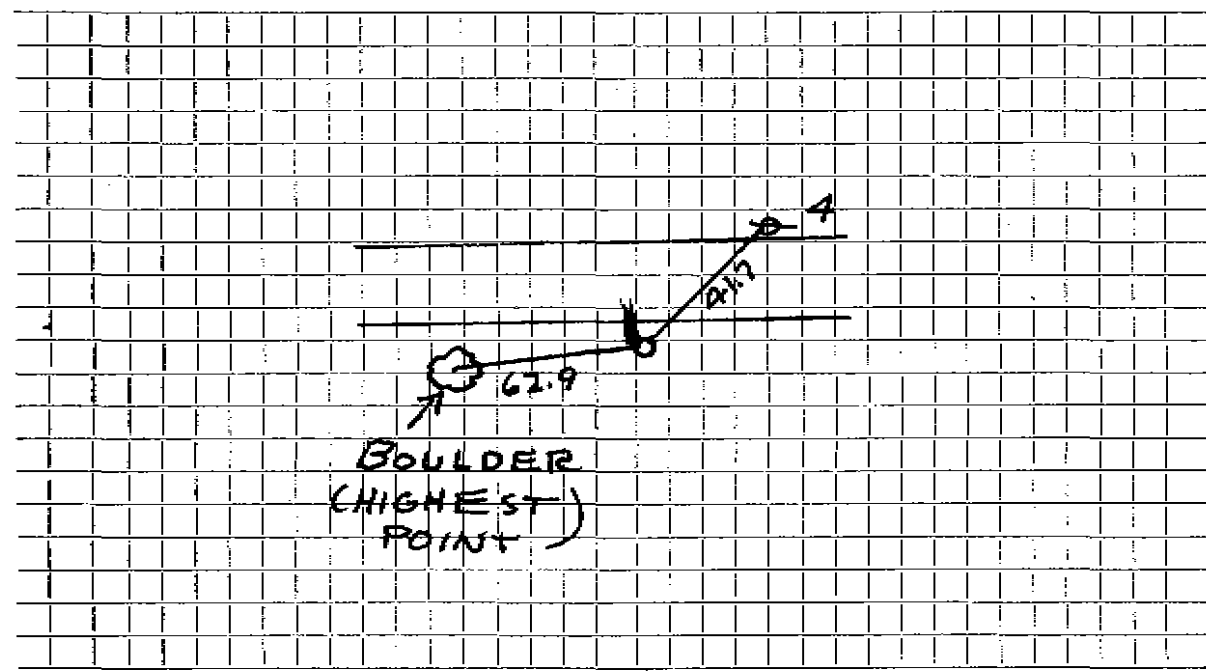

Connection made in DEMAR RD. Street. Work completed .....

Remarks: .....  
.....  
.....