

WATER SERVICE RECORD

Name Techbuilt, Inc.

Service No. 132

Address 8 DeMar Road

# 7213

Location

Repair  Renewal  New Service

Comm. 10-29-56


Date	Material	Amount	Total	Date	Curb to Main	Amount
6/21/56	Labor	1 95			NON CHARGE	
	10% overhead	20	2 15		Labor	1 95
	Owners Copper		---		8' 3/4" Coppertubing	3 85
	1 3/4 Cx 1/2 IWH Stop & Waste		4 96		1 3/4 C.Corp.Cock	4 64
	1 hr trucking		75		1 3/4" C.Curb Cock	5 94
			7 86		1 Box & Rod	4 62
					1 1/2 Straight tail pc.	50
					1 1/2 Offset tail pc.	50
						22 03
				6-1-56	Deposit	10 00
				10-29-56	Refund	2 14
						7 86

TOWN OF LEXINGTON — BOARD OF PUBLIC WORKS

WATER DIVISION

DATE \_\_\_\_\_

Sketch of Service Here

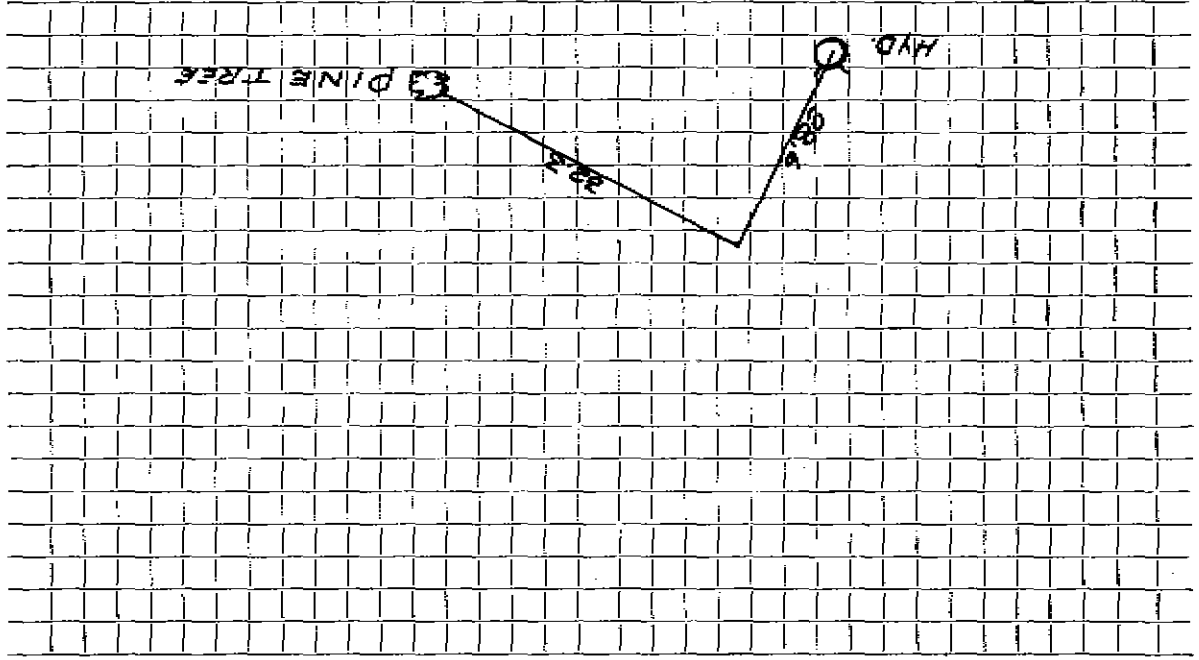

Connection made in \_\_\_\_\_ Street.

Work completed \_\_\_\_\_

Remarks: \_\_\_\_\_