

WATER SERVICE RECORD

Name **LARRY BELVIN**

Service No.

Address **10 Denver Street**

Location

Repair—~~Renewal~~ ~~by New Service~~ **W.O. 4444 PERMIT NO. 0993-A. CARDILLO & SONS**


Date	Material	Amount	Total	Date	Amount
11/3/75	Labor			7/30/1997	20' - 1" ϕ COPPER
	5' 8" of 3/4" copper				1 - 1" CORPORATION
	1 2" x 3/4" tee				
	1 3/4" close nipple				
	1 3/4" curb				
	1 curb rod				
	5 Yards gravel				
	2 Hrs. truck				
	2 Hrs. Shovel				

TOWN OF LEXINGTON — BOARD O
WATER DIVISION

SERVICE RENEWED FROM
 NEW 8" MAIN TO CURB STOP.

JULY 30, 1997
 BOOK 97-3

Sketch of Service Here

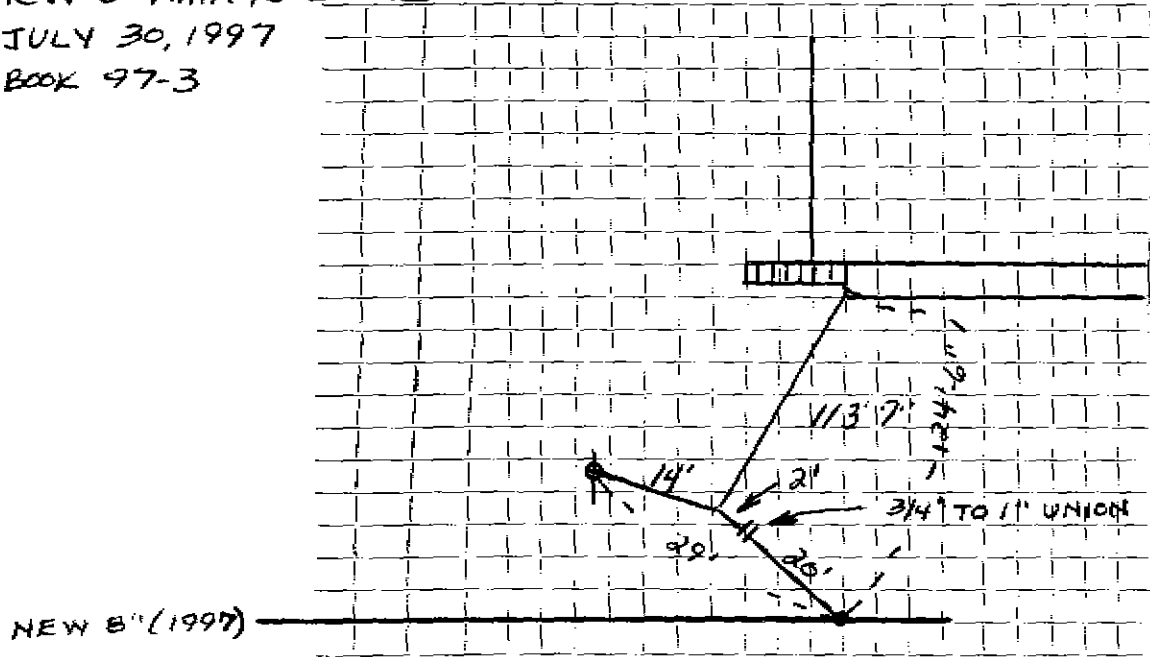

Connection made in Street. Work con
 Remarks: 7/97 NEW 8" MAIN, DENVER ST
 .. SERVICE'S TAPPED ON NEW MAIN. OLD SERVICE KILLED AT MAIN ..

