

WATER SERVICE RECORD

Name ~~J. A. Bix~~ GEORGE & JANET ATHENS

Service No. 77

Address 7 Denver Street

1811

Location

~~RENEWAL~~ Renewal ~~NEWS~~

WO #7356

PERMIT NO. 0995-A. CARDILLO & SONS

Comm 10-1-62


Date	Material	Amount	Total	Date	Amount	
6/18/62	Labor	38 51		6-13-62	Deposit	150 00
	10% O.H.	3 85	42 36	10-1-62	Retard	34 78
	80' 3/4" Copper Tubing @ .42		33 60			115 22
	1 3/4" Cx 1/2 IWH Stop & Waste		6 17			
	1 1" Close Brass Nipple		58			
	1 1" x 3/4" 2 Part Union		2 10			
	1 3/4" 3 Part Union		2 41	11/3/5	Labor	
	4 Hrs. Town Shovel @ 5.50		22 00	23'	3/4" copper	
	2 Hrs. Trucking @ 3.00		6 00	1	2" nipple 6" long	
			115 22	2"	1" Reducer coupling	
				1"	3/4" female adp.	
				1"	close adp.	
				1	3/4" curb	
				10	Yards gravel	
				2	Hrs. truck	
				2	Hrs. shovel	
				7/30/1997	10' - 1" Ø COPPER	

DATE _____

STON — BOARD OF PUBLIC WORKS


WATER DIVISION

Sketch of Service Here

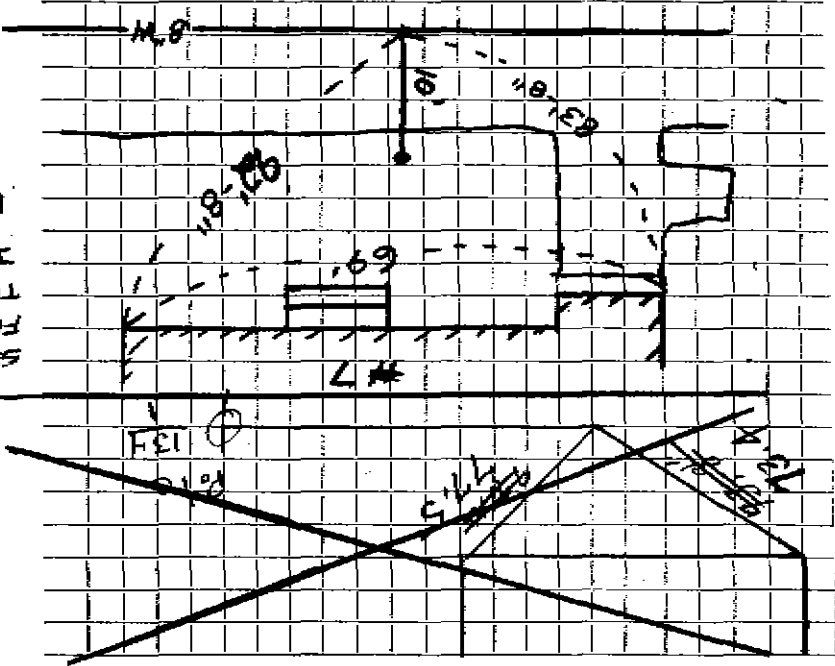

SERVICE RENEWED
FROM NEW MAIN
TO CURB STOP.
JULY 30, 1997
BOOK 97-3

Street. _____
Work completed _____
Service _____
Service Killed at Conf. 7/97
Tapped on New 8" Main

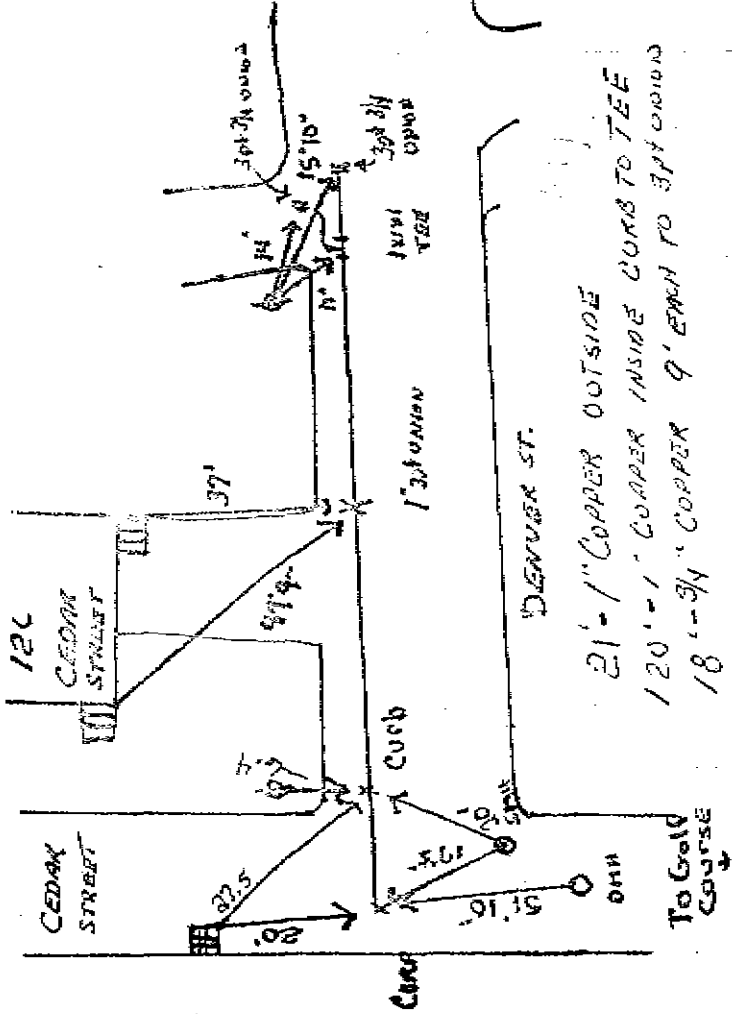

21'-1" COPPER OUTSIDE
120'-1" COPPER INSIDE CURB TO TEE
18'-3/4" COPPER 9' EACH TO SPOT ON

To Gold Course