

WATER SERVICE RECORD

Name Liberty Realty Trust (John MacNeil - Trustee)

Service No. 56

Address 15-17-19 Depot Square

Location

~~REPAIRS~~ ~~RENEWAL~~ - New Service*Account - 10-14-58*


Date	Material	Amount	Total	Date	Amount
5-21-58	Labor	7.45			25.00
	10% O.H.	.75	8.20	11-7-58	6.65
	4' 2" Cement Lined Pipe @	1.09	4.36		31.65
	1 2" Wheel Handle Valve		16.35		NON CHARGE
	1 2" x 1" L. L. Reducing Coup.		1.43		Labor
	1 2" Close Brass Nipple		.56	1	2" x 6" Cement L. Nipple
	12hr. Trucking @ .75		.75	1	2" Gate Valve
			31.65	1	Gate Box
				1	1" Straight tailpiece
				1	1" Offset tailpiece
					48.47

TOWN OF LEXINGTON — BOARD OF PUBLIC WORKS

WATER DIVISION

DATE _____

Sketch of Service Here

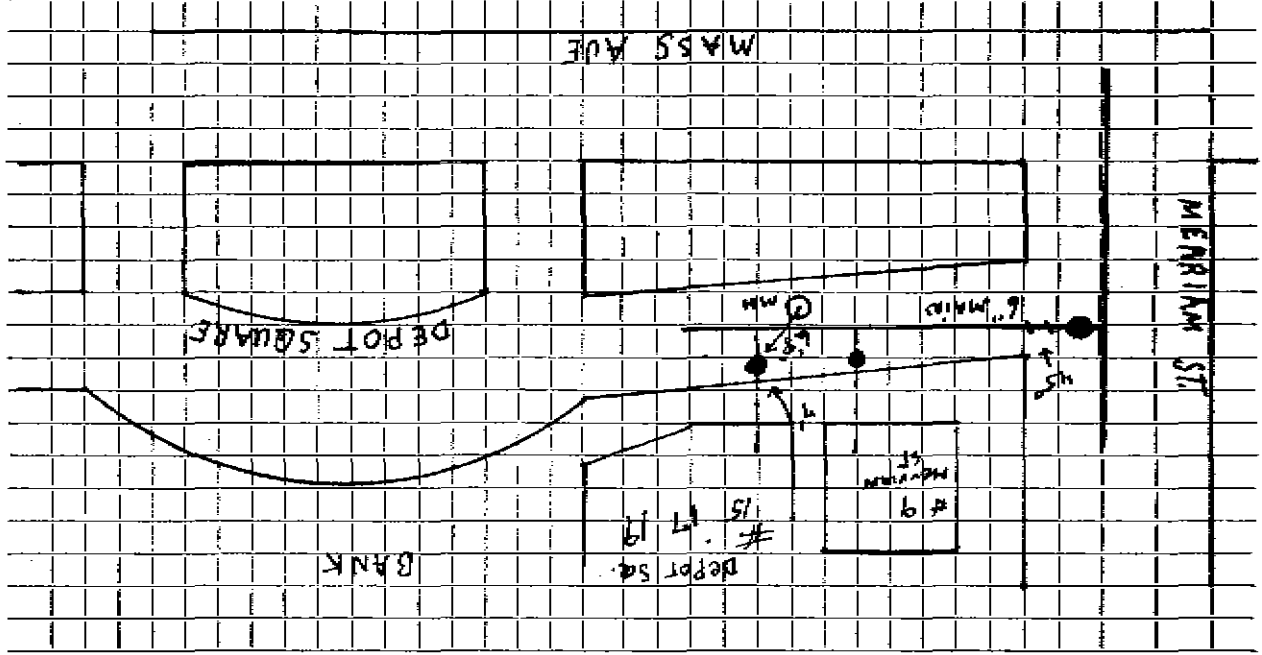

Connection made in Street. Work completed. Remarks: 12" x 6" T S + Gate - 2-45" beds 12-3-1981