

WATER SERVICE RECORD

4229

Name **Lexland Construction Co.**

Service No. 188

Address ~~110~~ ^{#19} Dewey Road Mail: Box 53, Newton 58, Mass.

Location Lot 9

Repair ~~Renewal~~ **New Service**

Comm 12-1-58

| Date | Material | Amount | Total | Date | Amount |
|---------|---------------------------------|--------|-------|-------------------------------|----------------|
| 9/29/58 | Labor | 3 62 | | 9-9-58 | Deposit 75 00 |
| | 10% Overhead | 36 | 3 98 | 10-1-58 | * Retand 23 31 |
| | 105' - 3/4" Copper Tubing @.37 | 38 85 | | | 51 69 |
| | 1-3/4" C 3 Part Union | 2 27 | | | NON CHARGE |
| | 1-3/4" C x 1/2 IWH Stop & Waste | 5 84 | | 12/20/56 | Labor 3 38 |
| | 1 hr. Trucking @.75 | 75 | | 30' 3/4" Copper tubing @.4396 | 13 19 |
| | | | 51 69 | 1 3/4" Corp Cock | 4 64 |
| | | | | 1 3/4" C Curb Cock | 5 94 |
| | | | | 1 Box & Rod | 4 62 |
| | | | | | 31 77 |
| | | | | 9/29/58 | |
| | | | | 1-1/2 Offset Tailpiece | 50 |
| | | | | 1-1/2 Straight Tailpiece | 50 |
| | | | | | 32 77 |


* Applied to WHC #156

DATE _____

TOWN OF LEXINGTON — BOARD OF PUBLIC WORKS

WATER DIVISION

Sketch of Service Here

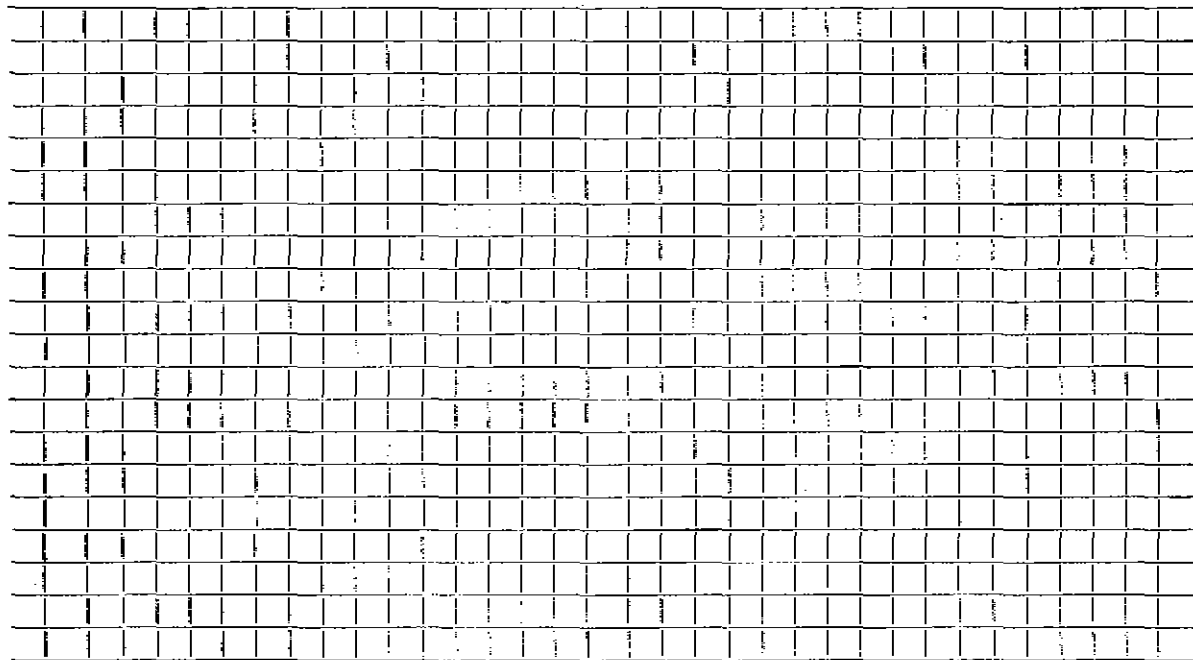

Connection made in Street. Work completed

Remarks:

.....

.....