

WATER SERVICE RECORD

2024 #4132
Service No. 189Name ~~Lot 4~~ Lexl and Construction Co.Address ~~Dewey Road~~ 18 Dewey Rd.

Location

Lot #4

~~Repair~~ ~~Renewal~~ New Service

Owner dug trench

Comm 12-15-58

Date	Material	Amount	Total	Date	Amount
9/29/58	Lab or	3 62		9-9-58	75 50
	10 % overhead	36	3 98	12-15-58	45 93
	50'-3/4" Copper tubing @.37		18 50		29 07
	1-3/4" C x 1/2 IWH stop & waste		5 84		
	1 hr. trucking @.75		75		NON CHARGE
			29 07	1/29/58	Labor
					23' 3/4" Copper tubing @ .37
					1 3/4" Corp Coel
					1 3/4" C Curb Cock
					1 Box & Rod
					1 Hr Trucking @ .75
					32 49
					1-1/2 straight tailpiece
					50
					1-1/2 offset tailpiece
					50
					33 49


* Only 4-29 To WHC #256

DATE _____

TOWN OF LEXINGTON — BOARD OF PUBLIC WORKS

WATER DIVISION

Sketch of Service Here

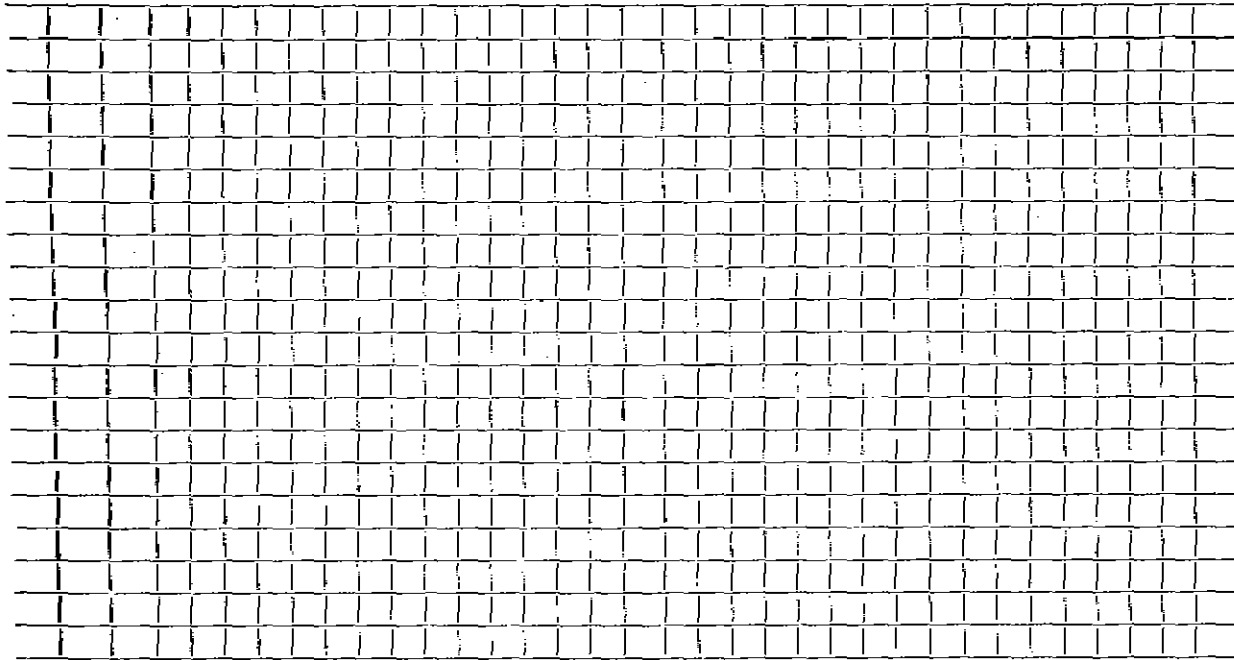

Connection made in Street. Work completed

Remarks:
.
.