

WATER SERVICE RECORD

#4043

Name Ben Franklin Homes

Service No. 113

Address 19 Dewey Road

Location Lot #3

Repair—Renewal—New Service


Comm 9-25-61

Date	Material	Amount	Total	Date		Amount
8-18-61	Labor	8.95		8-9-61	Deposit	150.00
	10% O.H.	.90	9.85	9-25-61	★ ReSound	79.01
	118' 3/4" Copper Tubing @.42		49.56			70.99
	1 3/4" C x 1/2 I.W.H. Stop & Waste		6.17		NON CHARGE	
	1 3/4" C 3 part union		2.41	5-6-58	Labor	16.89
	1 Hr. Trucking @3.00		3.00	35'	3/4" Copper tubing @.37	12.95
			70.99	1	3/4" C. Corp Cock	4.64
				1	3/4" C Curb Cock	6.03
				1	Box & Rod	5.00
				2	hrs. Pump @1.00	2.00
				1	hr. Trucking @.75	.75
						48.28
				1 1/2	Straight tailpiece	.50
				1 1/2	Offset tailpiece	.50
						49.26
				★	Apply 36.63 to bill #20	

TOWN OF LEXINGTON — BOARD OF PUBLIC WORKS

WATER DIVISION

Sketch of Service Here

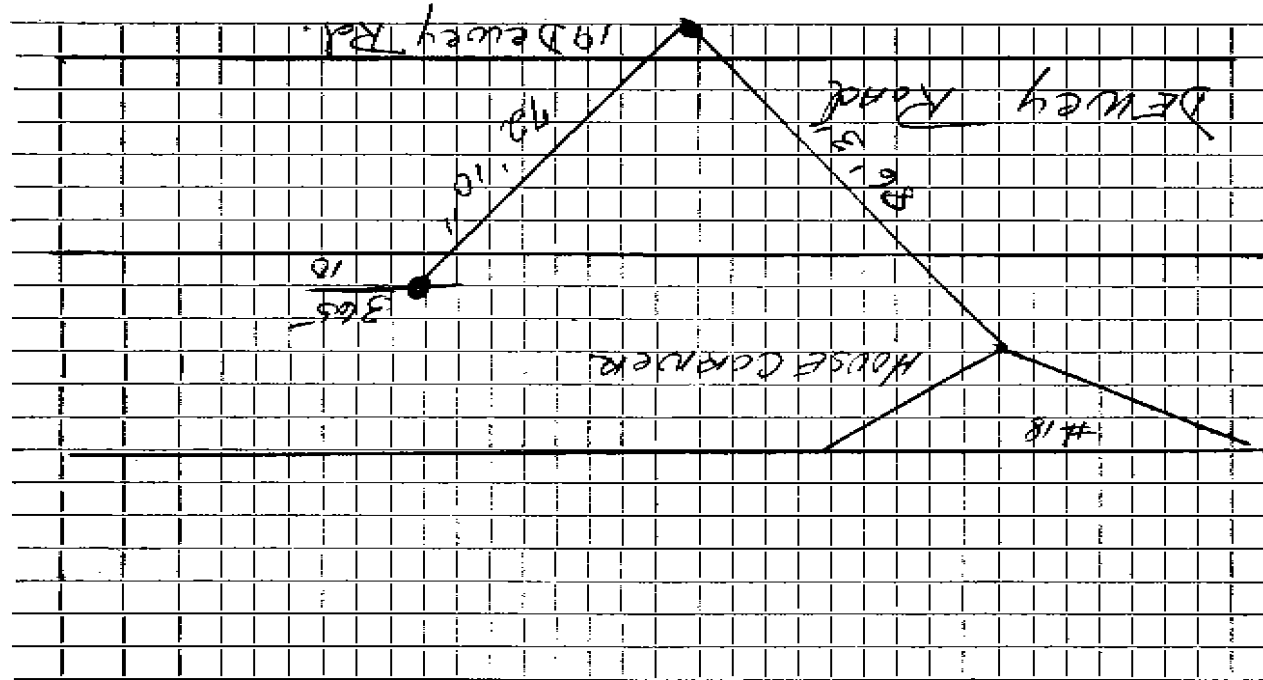

Connection made in Street. Work completed

Remarks:
.....
.....