

## WATER SERVICE RECORD

#6473

Name

Service No. 205

Address <sup>Lot</sup> Lexland Construction Co.  
~~1 Dewey Road~~ 20 Dewey Rd.

Location

~~Repair~~ ~~Renewal~~ New Service

Service was into Curb


Comm 12-15-58

Date	Material	Amount	Total	Date	Amount
10/7/58	Labor	5 72		10-6-58	25 00
	10% Overhead	57	6 29	12-15-58	1 02
	30'-3/4" Copper tubing @ .37		11 10		23 98
	1-3/4" Cx 1/2 IWH stop & waste		5 84		
	1 hr. Trucking @ .75		75		
			23 98		
				4/27/58	
				Labor	7 56
				37' 3/4" Copper tubing @ .37	13 69
				1 3/4" C Corp Cock	4 64
				1 3/4" C Curb Cock	6 09
				1 Box & Rod	5 00
				1 Hr Trucking @ .75	75
					37 67
				1-1/2 straight tailpiece	50
				1-1/2 offset tailpiece	50
					38 67

DATE \_\_\_\_\_

**TOWN OF LEXINGTON — BOARD OF PUBLIC WORKS**  
**WATER DIVISION**

Sketch of Service Here

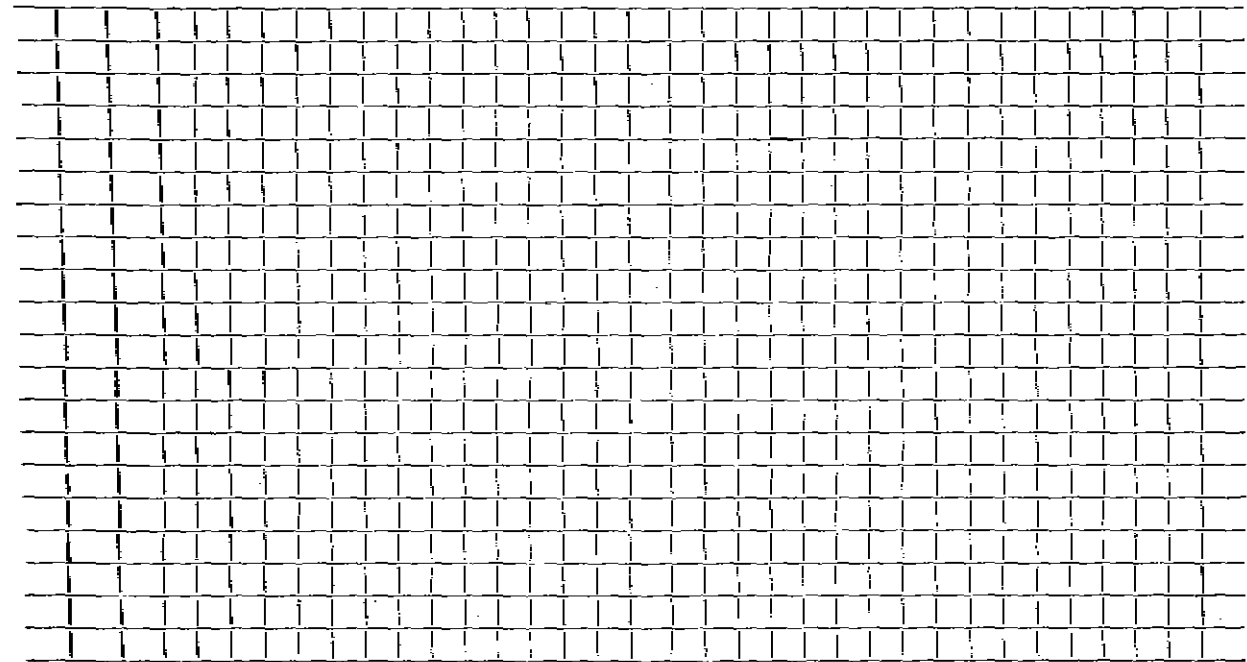

Connection made in ..... Street. Work completed .....

Remarks: .....  
.....  
.....