WATER SERVICE RECORD

Name	Service No.
Address 21 Dewey Bd.	
Location	
Renair—Renewal—New Service	


Date	Material	Amount	Total	Date	Amount
6/38/10					
	83'-1" Caper				
	7/7-0				
					·
			 	11	

`	Δ	T	F	

TOWN OF LEXINGTON - BOARD OF PUBLIC WORKS

WATER DIVISION

Sketch of Service Here

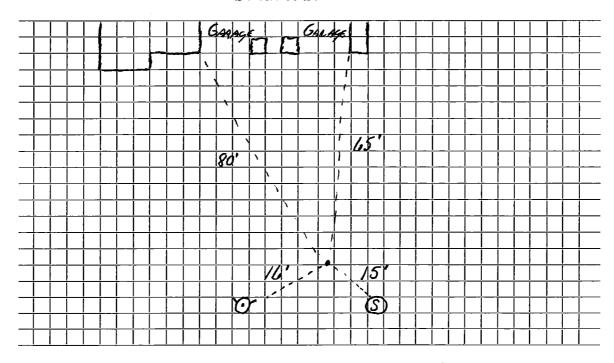

Connection made in	. Street.	Work completed	• • • • • • • • • • • • • • • • • • • •	• • • • • • • • •		• • • • • • •
Remarks:					• • • • • • • • • • • • • • • • • • • •	
			• • • • • • • • • • • • • • • • • • • •	• • • • • • • • •		• • • • • •