

# 5925

**WATER SERVICE RECORD**

**Name** Gerald D. Shirley

**Service No.**

**Address** 22 Dewey Road

**Location** *lot 44*


Reserve-Reserve New Service J.M.Lucente Permit #31

### Work completed

Street.

**Remarks:**

## Connecti

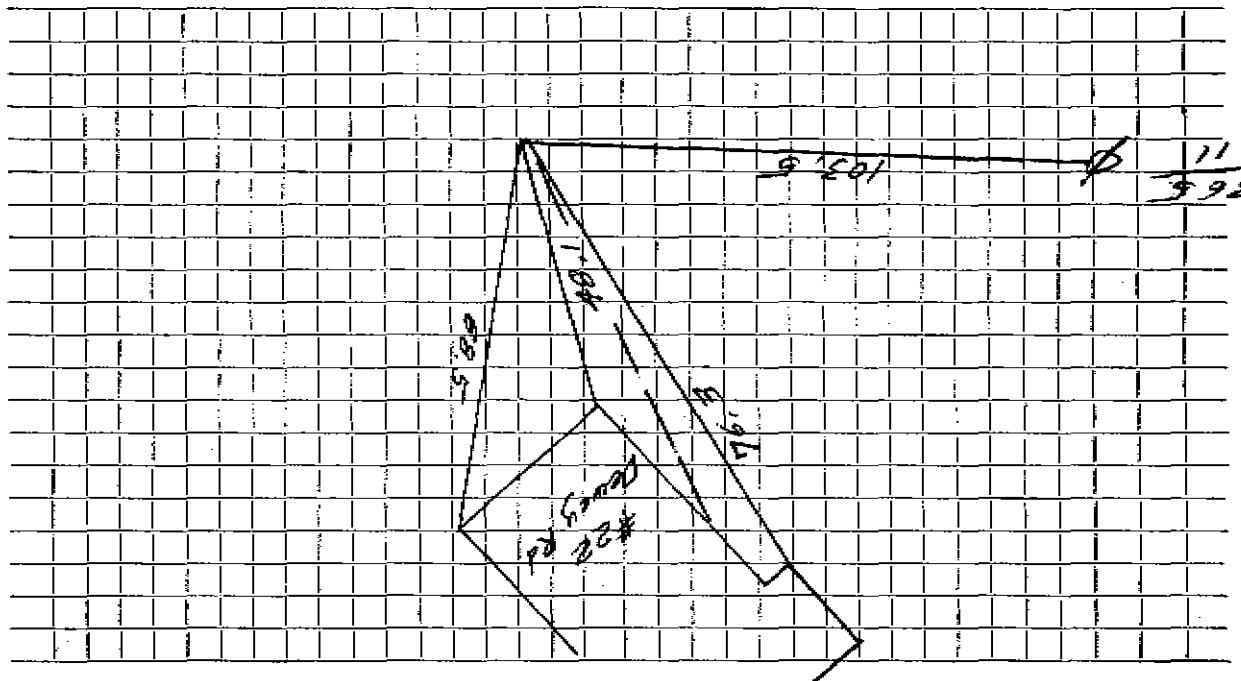

Sketch of Service Here

WATER DIVISION

TOWN OF LEXINGTON - BOARD OF PUBLIC WORKS

DATE