WATER SERVICE RECORD

Camina NIA

300261	Gerald D. Shirley				Service 140.	
Address	28 Dewey Road					
Location	n Let 47					
x Remi ex	Renewat New Service	J.M.Lucente	Permit #37			
Date	Material	Amount	Total	Date		Amount
July '64 2	3 3/4" Copper tubing					
,						
		<u> </u>				
	1		11	· ·	į.	!


_ ,						 									
!										_					
				··											•
	-					 		<u> </u>							
··			 		 			1				_			
					†	 						-			
						 					I	·		<u> </u>	
-					-	 						,	.		<u></u>
_ 			<u>_</u>		 	 	<u> </u>				<u> </u>			·	
					 .	 		 					.		<u> </u>
					 	 -				 					
						 				-					<u>'</u>
		_	<u> </u>		 	 		 	<u> </u>				·		
		_			 	 		 	<u> </u>						
			· ·		 	 		-		<u> </u>		-			
		<u> </u>			1		 	 	ļ	 					

DAT	E		
\sim		 	

TOWN OF LEXINGTON - BOARD OF PUBLIC WORKS

WATER DIVISION

Sketch of Service Here

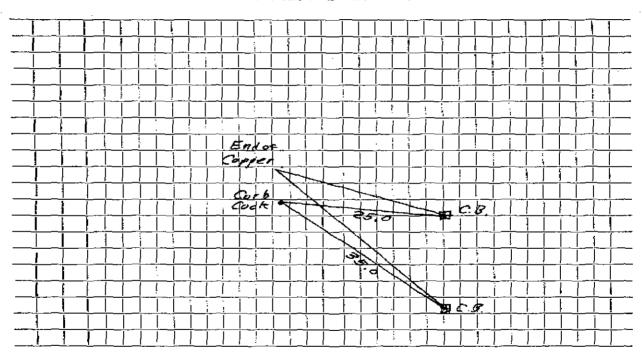

Connection made in	Street.	Work completed
Remarks:		
