

# WATER SERVICE RECORD

Name \_\_\_\_\_

Service No. \_\_\_\_\_

Address *31 Dewey Road*

Location \_\_\_\_\_


Repair—Renewal—New Service \_\_\_\_\_

Date	Material	Amount	Total	Date	Material	Amount	Total
<i>9/17/48</i>	<i>160'</i>	<i>1" Copper</i>					
	<i>1</i>	<i>1" C x 3/4" I.W.H.S &amp; W</i>					
	<i>2</i>	<i>1" C x 1" C 3 pt. Union</i>					
					<i>OUTSIDE</i>		
				<i>9/18/48</i>	<i>33'</i>	<i>1" Copper tubing</i>	
					<i>1</i>	<i>1" C Corp Cock</i>	
					<i>1</i>	<i>1" C x 1" C Curb Cock</i>	
					<i>1</i>	<i>Box &amp; Rod</i>	

DATE \_\_\_\_\_

TOWN OF LEXINGTON — BOARD OF PUBLIC WORKS  
WATER DIVISION

Sketch of Service Here

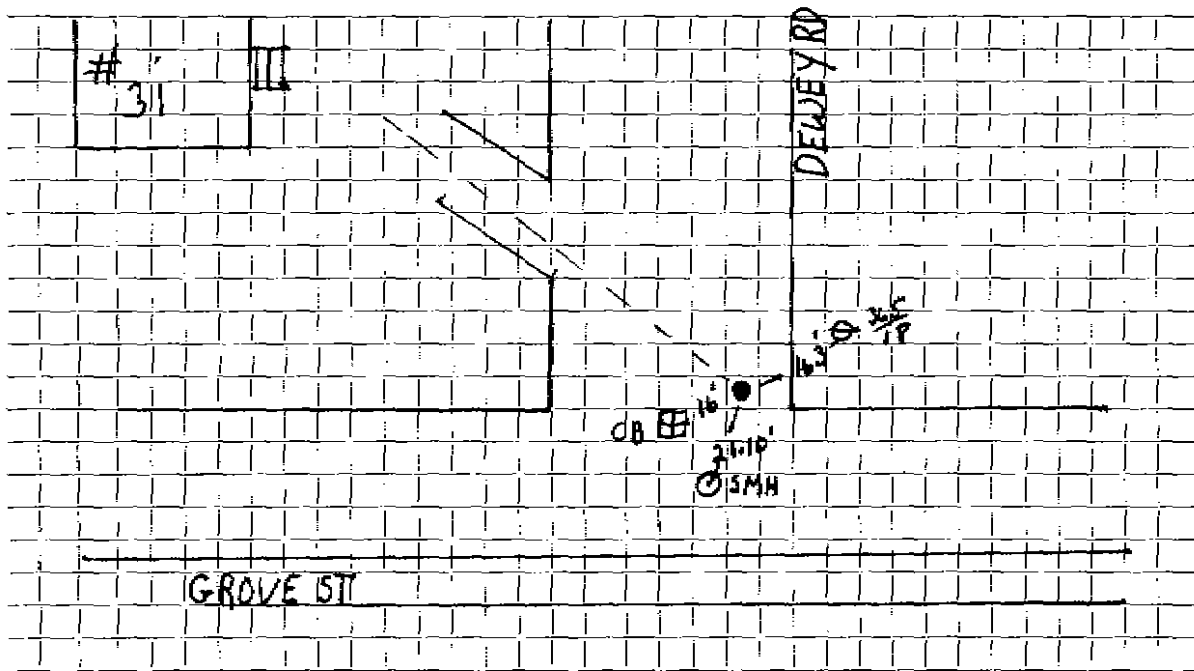

Connection made in ..... Street. Work completed .....

Remarks: CHANGED FROM 169 GROVE ST  
.....  
.....