

WATER SERVICE RECORD

Service No. 206

Name Lexland Construction Co.

Address 8 ~~XXXXX~~ Dewey Road

Location Lot # 11

~~Repair~~ ~~Renewal~~ New Service

Com. on 12-15-58


Date	Material	Amount	Total	Date	Amount
10/7/58	Lab or	9 53		10-6-58	25 00
	10% overhead	95	10 48	10-15-58	14 27
	60'-3/4" Copper tubing @.37		22 20		39 27
	1 hr. trucking @.75		75		<u>NON CHARGE</u>
	1-3/4" C x 1/2 IWH, stop & waste		5 84	12/20/56	Labor 3 39
			39 27		38' 3/4" Copper tubing @.4396 16 70
					1 3/4" C Corp Cock 4 64
					1 3/4" C Curb Cock 5 94
					1 Box & Rod 4 62
					1 Hr. trucking @.75 75
					36 04
					1-1/2 straight tailpiece 50
					1-1/2 offset tailpiece 50
					<u>37 04</u>

DATE _____

TOWN OF LEXINGTON — BOARD OF PUBLIC WORKS

WATER DIVISION

Sketch of Service Here

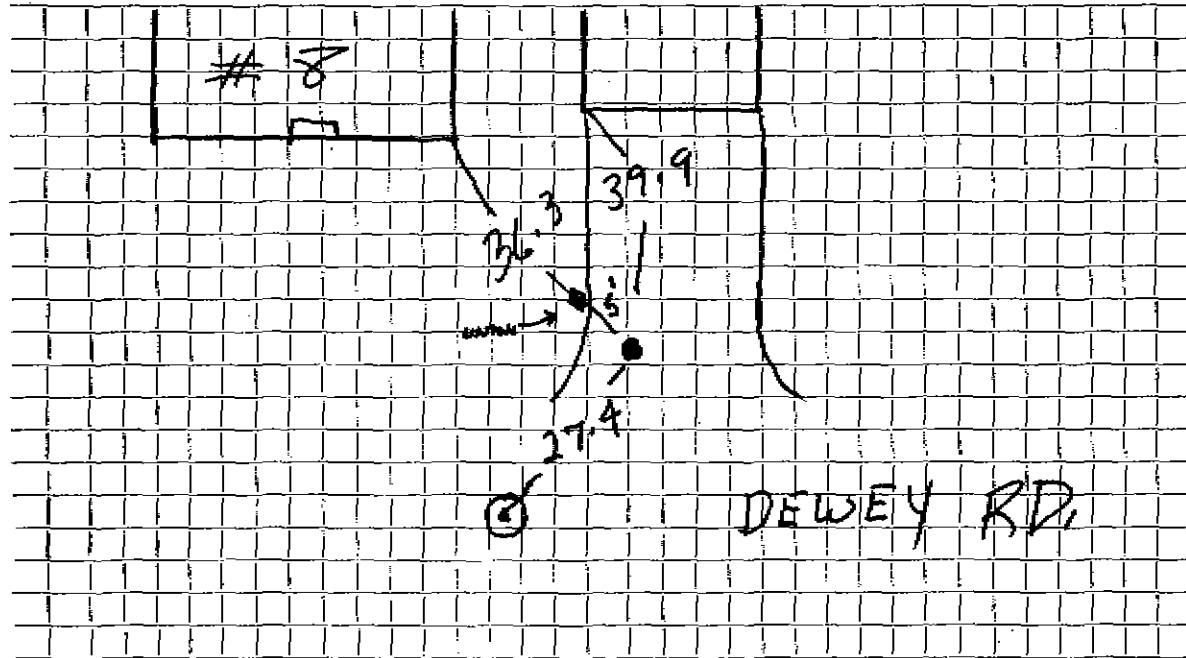

Connection made in _____ Street. Work completed _____

Remarks: 6-93 Repair 5' copper 1-completion from curb _____

