




DATE 3/6/2020

TOWN OF LEXINGTON — BOARD OF PUBLIC WORKS  
WATER DIVISION

Sketch of Service Here

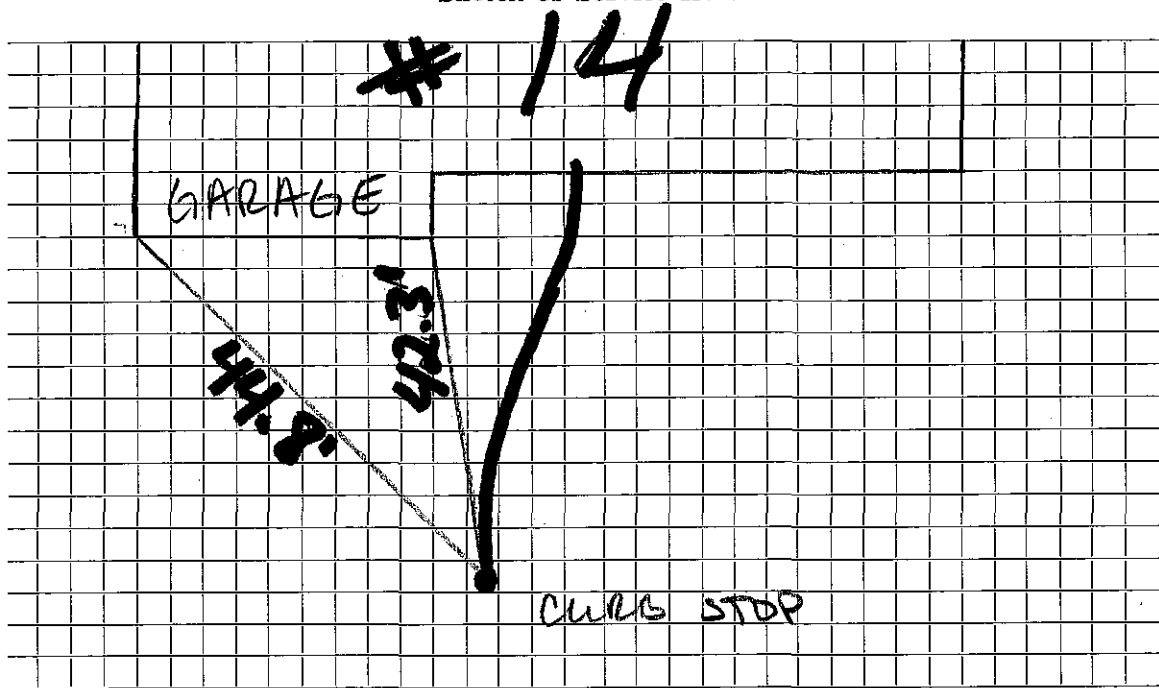

Connection made in Dexter Rd Street. Work completed .....

Remarks: .....