

Name W. R. Colwell

Service No. 725

Address 122 Rawson Avenue, Arlington

#3359

10 Dexter Rd.

Locatio Dexter Road #Lot #25

Kind of Pipe

Size

Size of Main

Repair - Renewal - New Service

Location

Date	Material	Amount	Total	Date	Amount
March 20	3 hrs. @ 55¢	1 65			
	2 " @ 60¢	1 20	2 85	March 13	19 40
	10% Overhead-labor		29		
	30' 1" C.L. Pipe @20¢		6 00		
	1 1" L.L. Coup.		75	11/5/84	26' 3/4" Copper
	1 1" L.L.Elbow		90		1 3/4" Adapter Corp.
	1 1" Brass Nipple		40		1 1" Style 138
	1 S. & W.		2 75		1 4"x1" CL Nipple
	Trucking		75		1 1" L. Coupling
			14 69		1 3/4" Curb
			4 71		10 Tons - Gravel
			19 40		2 Tons - Cold Patch
	Labor				Patch - 25'x 8

March 20
Comm. to Rawson Rd
5-8-35 & 4-6-37

Hadley Press, Inc., Lexington

June 7-735 Approved

DATE March 13, 1935

TOWN OF LEXINGTON—BOARD OF PUBLIC WORKS

WATER DIVISION

The undersigned applies for a supply of water at No. Lot # 25, West St. St. and hereby agrees to comply with the rules and regulations as now, or at any future time, established by the Board of Selectmen.

Am't. of Estimate \$ 14⁴⁰ + 5.⁰⁰ = \$19.40


Owner W. R. Colwell

Am't. Paid \$ 14⁴⁰

Address 132 Rawson Rd
Arlington

Builder _____

Sketch of Service Here

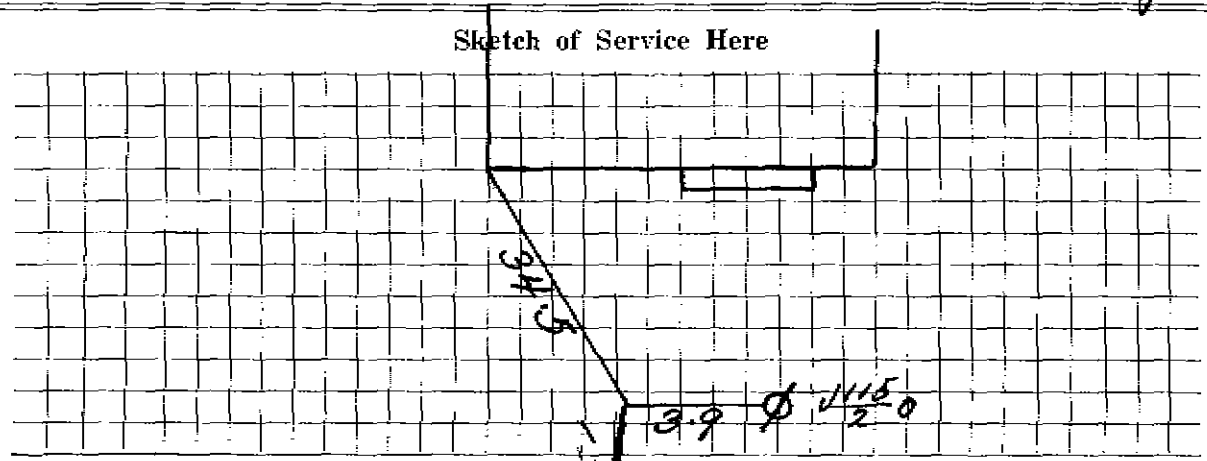

Connection made in _____

1 1/2 feet.

Work completed _____ 19

Remarks:

