

WATER SERVICE RECORD

Name John H. Ayvazian

Service No. 30

Address 11 Dexter Rd.

Location

~~Repair-Renewal~~ ~~New Service~~ WO #4576


Date	Material	Amount	Total	Date	Amount
6/14/76	labor	100.96		6-9-76	Deposit 200.00
6/16/76	labor	39.96	140.92	7-7-76	16.25
	10%OH	14.09	155.01		216.80
35'	3/4" Copper Tubing @ .65		22.75		OUTSIDE
1	Wheel Handle		14.53	6/14/76	labor 138.83
3	yds. loam @ 4.50		13.50	6/15/76	labor 39.96
4	lbs. grasseed @ .39		1.56	7/12/76	labor 21.33
1	hr. truck		3.00	10'	3/4" <sup>Copper</sup> <del>Cast Iron</del> Pipe @ .65
1	hr. shovel @ 6.50		6.50	1	3/4" Curb
			216.85	1	Box and Rod
				1	3/4" X 5/8" LF Adpt.
					Driveway 8 X 10
					Street 6 X 11
				4	hrs. shovel @ 6.50
				1 1/2	hrs. truck @ 3.00
					368.60

DATE \_\_\_\_\_

TOWN OF LEXINGTON — BOARD OF PUBLIC WORKS

WATER DIVISION

Sketch of Service Here

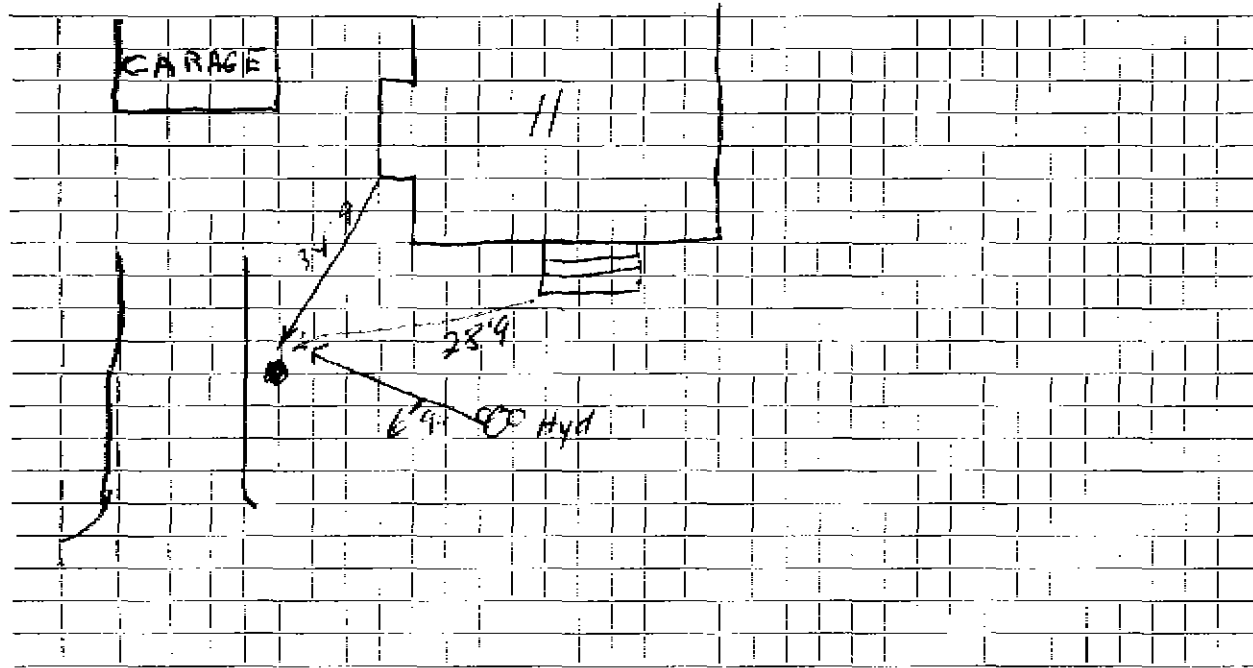

Connection made in ..... Street. Work completed .....

Remarks: .....  
.....  
.....