

Name E. E. MacPhee

Service No. ~~155~~ 729
341

Address 37 Vaille Avenue, Lexington
18 Dexter Road

Location

18 Dexter Road

Kind of Pipe

Size

Size of Main

Repair—Renewal—New Service

Location

Date	Material	Amount	Total	Date	Amount
1941					
Dec. 28	2 hrs. @ 60¢	1 20		Dec. 22 1941	30.00
Com 7/29/41	10% Overlead	12	1 32	Dec 30 1941	171
	35' 3/4" Copper tubing @ 18¢	6 18	6 65		28 39
	1 3/4" @ 2 1/2" I.S. & W.	2 50	2 50		
	1 hr. trucking		75		
	Trench repairs		13 32		
			24 54		
	Construction charge		3 75		
			28 29		
	Labor				

Hadley Press, Inc., Lexington

DATE _____

TOWN OF LEXINGTON—BOARD OF PUBLIC WORKS

WATER DIVISION

The undersigned applies for a supply of water at No. _____ St. and hereby agrees to comply with the rules and regulations as now, or at any future time, established by the Board of Selectmen.

Am't. of Estimate \$ _____


Owner _____

Am't. Paid \$ _____

Address _____

Builder _____

Sketch of Service Here

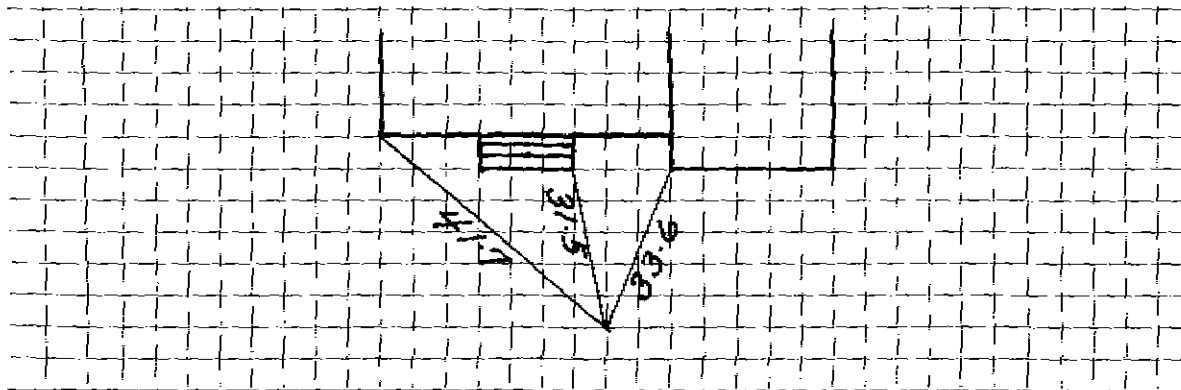

Connection made in _____ Street.

Work completed _____ 19

Remarks: